

MAY 15 1997

LAND CORNER RECORDATION CERTIFICATE
Filing Requirement of Act 74, Mich. P.A. 1970

For corners in
CHEBOYGAN COUNTY

(County)	Located In:	Corner Code #
1. Public Land Survey	T 37N R 3W	M-10
	T R	
	T 37 R 2W	A-10
	T R	
2. Property Controlling in Section	S T R	
	S T R	
3. Miscellaneous Property in Sec.	S T R	
	S T R	

RECEIVED FOR RECORD
96 OCT 30 PM 12:37

Joanna Spray
CLERK/REGISTER
CHEBOYGAN COUNTY, MICHIGAN
Register of Deeds Stamp & File Number

4. Lot No. _____, Recorded Plat _____

5. Private Claims _____

I, JAMES H. GRANGER, in a field survey on SEPTEMBER 24, 19 96 do hereby state that under requirements of P.A. 74, Michigan P.A. of 1970, the corner points mentioned in lines 1 and 2 above were in conformance with regulations and rules therefore as required in the current manual of survey instructions of the United States Department of the Interior, Bureau of Land Management or by a decree of a Court of Law and for that the corner points mentioned in lines 3, 4 and 5 above were in conformance with the rules of the Michigan Board of Land Surveyors or by a Decree of a Court of Law; established, re-established, monumented, recovered, found as expressed below:

A	B	C	D	E	F	G	H	I	J	K	L	M
1												
2	6	5		4		3		2		1		
3												
4	7	8		9		10		11		12		
5												
6	18	17		16		15		14		13		
7												
8	19	20		21		22		23		24		
9												
10	30	29		28		27		26		25		
11												
12	31	32		33		34		35		36		
13												

NOTE: Not more than 2 corners, all in the same town and range, may be recorded on this certificate.


A. Description of original monument and accessories and/or subsequent restoration:

1840 Original Survey John Mullett	Set wood post 12" Beech S52°W 8 lks 6" Sugar N07°E 18 lks
1972 Survey Orlando Doyle # 7319	Found 3/4" iron bar

B. Description of corner evidence found and/or method applied in restoring or reestablishing corner:

Found 3/4" rod and two witnesses.

Marvin A. P...

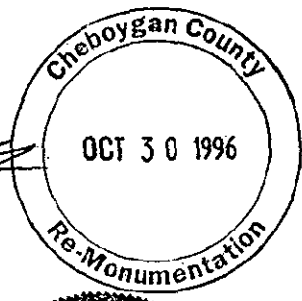


LIBER 010 PAGE 189

C. Description of monument for corner and accessories established to perpetuate locating the position of the corner:

also corner A-10, T37N, R2W

Set 5/8" x 30" rebar inside 3/4" pipe with Remonumentation Cap

3/4" Rod			
30" Maple	N19°W	63.69'	Fd nail & washer
24" Maple	S89°W	25.15'	Fd nail & washer
30" Maple	S89°E	34.89'	Set nail w/tag
4" White Pine	S27°W	91.00'	Set nail w/tag

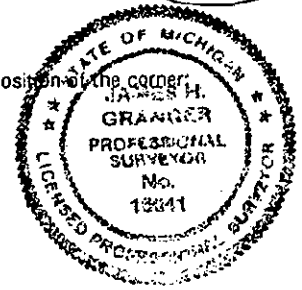

Signed by James H. Granger
Surveyor's Michigan License No. 16041

Date 10-10-96