SURVEY & REMONUMENTATION

FEB 26 1998

CHEBOYGAN COUNTY REMONUMENTATION CORNER

LAND CORNER RECORDATION CERTIFICATE
Filing Requirement of Act 74, Mich. P.A. 1970

For corners in

CHEBOYGAN SECTION
(County)

Located In: Corner Code #

RECEIVED FOR RECORD 12-18-97
at 11:20 O'Clock A M

Joanne Spray
CLERK/REGISTER
CHEBOYGAN COUNTY, MICHIGAN

Register of Deeds Stamp & File Number

		38N 2W		B-13
1. Public Land Survey		T 37N R 2W		B-1
		T___ R___		
		T___ R___		
		T___ R___		
2. Property Controlling	S___	T___ R___		
in Section	S___	T___ R___		
3. Miscellaneous	S___	T___ R___		
Property in Sec.	S___	T___ R___		

4. Lot No. _____ , Recorded Plat _____
5. Private Claims _____

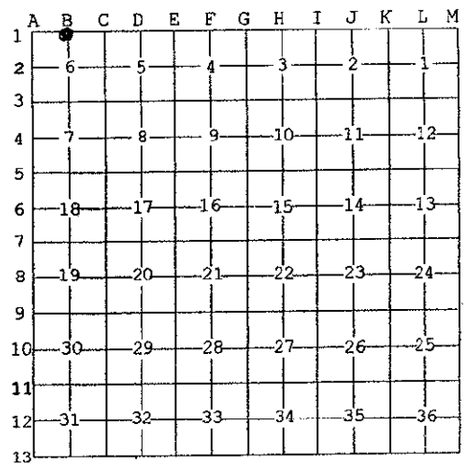

I, JAMES H. GRANGER, in a field survey on JULY 15, 19 97 do hereby state that under requirements of P.A. 74, Michigan P.A. of 1970, the corner points mentioned in lines 1 and 2 above were in conformance with regulations and rules therefore as required in the current manual of survey instructions of the United States Department of the Interior, Bureau of Land Management or by a decree of a Court of Law and /or that the corner points mentioned in lines 3, 4 and 5 above were in conformance with the rules of the Michigan Board of Land Surveyors or by a Decree of a Court of Law; established, re-established, monumented, recovered, found as expressed below:

NOTE: Not more than 2 corners, all in the same town and range, may be recorded on this certificate.

A. Description of original monument and accessories and/or subsequent restoration:

B-1	1840 Original Survey John Mullett	Set wood post 40" Hemlock	N45°W	11 lks
		12" Birch	N42°E	10 lks
	1972 Survey Orlando Doyle #7319	Metal Monument		
	1977 LCRC Orlando Doyle #7319	1 1/4" Pipe		
	1985 Survey Orlando Doyle #7319	Metal Monument		

Cheboygan County
SEP 25 1997
James H Granger
Re-Monumentation

B. Description of corner evidence found and/or method applied in restoring or reestablishing corner:

B-1 No evidence of monument found. Found 2 witnesses, grown over, per Doyle LCRC. Set 5/8" rebar and remonumentation cap per existing witnesses.

C. Description of monument for corner and accessories established to perpetuate locating the position of the corner:

B-1 5/8" rebar and Remonumentation Cap

14" Pine	S52°W	43.27'	Set tag #16041
PP	S 6°W	31.79'	Set tag #16041
14" Pine	N50°E	44.46'	Set tag #16041
8" Pine	N28°W	22.52'	Set tag #16041

LIBER 011 PAGE 24

Signed by James H Granger Date Nov. 17, 1997 Surveyor's Michigan License No. 16041

STATE OF MICHIGAN
JAMES H. GRANGER
PROFESSIONAL SURVEYOR
No. 16041
LICENSED PROFESSIONAL SURVEYOR

FORM APPROVED BY MICHIGAN STATE BOARD OF PROFESSIONAL SURVEYORS, JAN. 28, 1971
REVISED 14,1976
REVISED JAN., 19
REVISED OCT., 19