CHEBOYGAN COUNTY REMONUMENTATION CORNER

LAND CORNER RECORDATION CERTIFICATE
Filing Requirement of Act 74, Mich. P.A. 1970

RECEIVED FOR RECORD
99 DEC -6 PM 2:45

Vicky Pszczynski
CLERK/REGISTER
CHEBOYGAN COUNTY MICHIGAN

Register of Deeds Stamp & File Number

For corners in

CHEBOYGAN (County) Located In: Corner Code #

1. Public Land Survey		T 37N R 2W	B-5
		T___ R___	
		T___ R___	
		T___ R___	
2. Property Controlling	S___	T___ R___	
in Section	S___	T___ R___	
3. Miscellaneous	S___	T___ R___	
Property in Sec.	S___	T___ R___	

4. Lot No. _____ , Recorded Plat _____

5. Private Claims _____

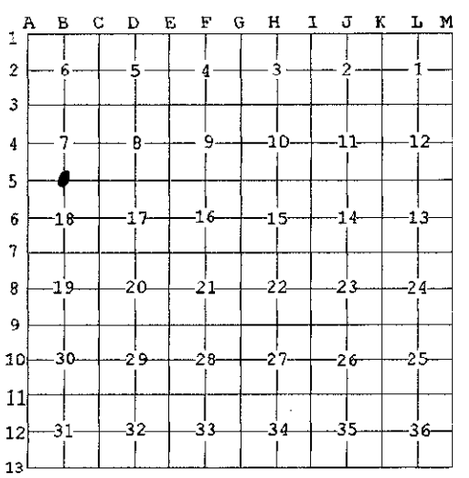

I, JAMES H. GRANGER, in a field survey on JULY 9, 19 99 do hereby state that under requirements of P.A. 74, Michigan P.A. of 1970, the corner points mentioned in lines 1 and 2 above were in conformance with regulations and rules therefore as required in the current manual of survey instructions of the United States Department of the Interior, Bureau of Land Management or by a decree of a Court of Law and /or that the corner points mentioned in lines 3, 4 and 5 above were in conformance with the rules of the Michigan Board of Land Surveyors or by a Decree of a Court of Law; established, re-established, monumented, recovered, found as expressed below:

NOTE: Not more than 2 corners, all in the same town and range, may be recorded on this certificate.

A. Description of original monument and accessories and/or subsequent restoration:

1855 GLO Resurvey	Set wood post	7" Hemlock	N 5°E	3 lks
Harvey Mellen		16" Hemlock	S26°E	4 lks

SURVEY & REMONUMENTATION
MAR 03 2000
SECTION

Cheboygan County
OCT 7 1999
James H Granger
Re-Monumentation

B. Description of corner evidence found and/or method applied in restoring or reestablishing corner:

No original evidence found. Established position by single proportionate measurement between A-5 and C-5

C. Description of monument for corner and accessories established to perpetuate locating the position of the corner

5/8" rebar with Remonumentation Cap

10" Maple	South	3.23'	Nail & tag #16041
6" Maple	S74°E	15.06'	Nail & tag #16041
7" Maple	N 2°W	13.51'	Nail & tag #16041
10" Maple	S78°W	12.88'	Nail & tag #16041

STATE OF MICHIGAN
JAMES H. GRANGER
PROFESSIONAL SURVEYOR
No. 16041
LICENSED PROFESSIONAL SURVEYOR

Signed by James H Granger Date November 12, 1999

Surveyor's Michigan License No. 16041

FORM APPROVED BY MICHIGAN STATE BOARD OF PROFESSIONAL SURVEYORS, JAN. 28, 1971
REVISED 14,1975
REVISED JAN., 1983
REVISED OCT., 1993