

SURVEY & REMONUMENTATION

CHEBOYGAN COUNTY REMONUMENTATION CORNER

MAY 05 1997

LAND CORNER RECORDATION CERTIFICATE

Filing Requirement of Act 74, Mich. P.A. 1970

COMMISSION

For corners in

CHEBOYGAN
(County)

Located In:

Corner Code #

- | | | | | | |
|--------------------------------------|---|------------|---|-----------|-------------|
| 1. Public Land Survey | T | <u>37N</u> | R | <u>2W</u> | <u>B-11</u> |
| | T | _____ | R | _____ | _____ |
| | T | _____ | R | _____ | _____ |
| | T | _____ | R | _____ | _____ |
| 2. Property Controlling in Section | S | _____ | T | _____ | _____ |
| | S | _____ | T | _____ | _____ |
| 3. Miscellaneous Property in Section | S | _____ | T | _____ | _____ |
| | S | _____ | T | _____ | _____ |

RECEIVED FOR RECORD
96 OCT -1 PM 3: 57

James Gray
CLERK/REGISTER
CHEBOYGAN COUNTY, MICHIGAN
Register of Deeds Stamp & File Number

4. Lot No. _____, Recorded Plat _____
5. Private Claims _____

I, Ronald Bischer, in a field survey on September 3, 19 96, do hereby certify that under requirements of P.A. 74, Michigan P.A. of 1970, the corner points mentioned in lines 1 and 2 above were in conformance with regulations and rules therefore as required in the current manual of survey instructions of the United States Department of the Interior, Bureau of Land Management or by a decree of a Court of Law and/or that the corner points mentioned in lines 3, 4 and 5 above were in conformance with the rules of the Michigan Board of Professional Surveyors or by a Decree of a Court of Law; established, re-established, monumented, re-monumented, recovered, found as expressed below:


A	B	C	D	E	F	G	H	I	J	K	L
2	6	5	4	3	2	1					
3											
4	7	8	9	10	11	12					
6											
6	18	17	16	15	14	13					
7											
8	19	20	21	22	23	24					
8											
10	30	29	28	27	26	25					
11											
12	31	32	33	34	35	36					
13											

NOTE: Not more than 4 corners, all in the same town and range, may be recorded on this certificate.

A. Description of original monument and accessories and/or subsequent restoration:

1855 Resurvey - Harvey Mellen
Set Wood Post
Beech 16" S22° W 16 lks
Hemlock 36" N15° W 8 lks

1973 Orlando Doyle #7319
Set 3/4" pipe
Set three witnesses

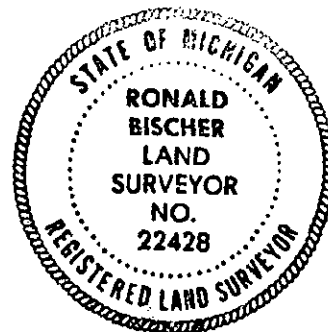


B. Description of corner evidence found and/or method applied in restoring or reestablishing corner:

Found 3/4" pipe and Doyle's three witnesses

Replaced with Cheboygan County Remonumentation Monument in Monument Box

Marion G. Ross

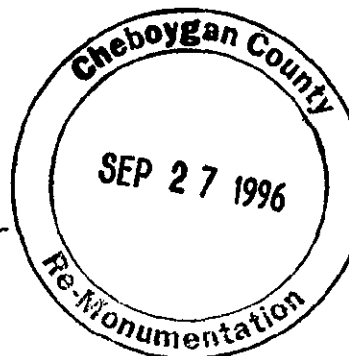

C. Description of monument for corner and accessories established to perpetuate locating the position of the corner:

Cheboygan County Remonumentation Monument

N04° E 53.76' 18" Maple
N34° E 93.30' SW Cor of House
S38° E 91.20' Power Pole
North 40.00' 5/8" Rod & Cap #16051

LIBER 010 PAGE 148

Signed by Ronald R. Bischer

Date Sept 18, 1996

Surveyor's Michigan License No. 22428