

LAND CORNER RECORDATION CERTIFICATE  
Filing Requirement of Act 74, Mich. P.A. 1970 99DEC -6 PM 2:46

For corners in

CHEBOYGAN Located In: Corner Code #  
(County)

1. Public Land Survey T 37NR 2W C-2  
T R  
T R  
T R

2. Property Controlling S T R  
in Section S T R

3. Miscellaneous S T R  
Property in Sec. S T R

*Silvia Agostynski*  
CLERK/REGISTER  
CHEBOYGAN COUNTY MICHIGAN

Register of Deeds Stamp & File Number

4. Lot No. \_\_\_\_\_, Recorded Plat \_\_\_\_\_  
5. Private Claims \_\_\_\_\_

	A	B	C	D	E	F	G	H	I	J	K	L	M
1													
2	6		5			4			3			2	1
3													
4	7		8			9			10			11	12
5													
6	18		17			16			15			14	13
7													
8	19		20			21			22			23	24
9													
10	30		29			28			27			26	25
11													
12	31		32			33			34			35	36
13													

I, JAMES H. GRANGER, in a field survey on JULY 12, 19 99 do hereby state that under requirements of P.A. 74, Michigan P.A. of 1970, the corner points mentioned in lines 1 and 2 above were in conformance with regulations and rules therefore as required in the current manual of survey instructions of the United States Department of the Interior, Bureau of Land Management or by a decree of a Court of Law and for that the corner points mentioned in lines 3, 4 and 5 above were in conformance with the rules of the Michigan Board of Land Surveyors or by a Decree of a Court of Law; established, re-established, monumented, recovered, found as expressed below:

NOTE: Not more than 2 corners, all in the same town and range, may be recorded on this certificate.


A. Description of original monument and accessories and/or subsequent restoration:

1855 GLO Resurvey Set wood post 10" Beech N32°E 20 lks  
Harvey Mellen 12" Beech S11 1/2°E 26 lks

SURVEY &  
RE-MONUMENTATION

MAR 03 2000

SECTION

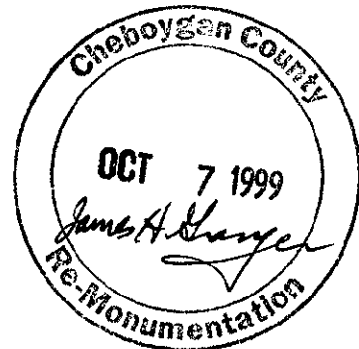

B. Description of corner evidence found and/or method applied in restoring or reestablishing corner:

No original evidence found. Established position by single proportionate measurement between C-1 and C-3

C. Description of monument for corner and accessories established to perpetuate locating the position of the corner:

5/8" rebar with Remonumentation Cap  
Fence Corner S75°E 33.62' Nail & tag #16041  
32" Maple N29°E 60.77' Nail & tag #16041  
Fence corner West 51.74' Nail & tag #16041  
14" Quad Maple S47°W 39.87' Nail & tag #16041



Signed by James H. Granger  
Surveyor's Michigan License No. 16041

Date November 12, 1999