

CHEBOYGAN COUNTY REMONUMENTATION CORNER RECEIVED FOR RECORD

LAND CORNER RECORDATION CERTIFICATE

Filing Requirement of Act 74, Mich. P.A. 1970

99 DEC -6 PM 2: 47

For corners in

<u>CHEBOYGAN</u> (County)	Located In:	Corner Code #
1. Public Land Survey	T <u>37NR 2W</u>	<u>C-4</u>
	T <u> </u> R <u> </u>	<u> </u>
	T <u> </u> R <u> </u>	<u> </u>
	T <u> </u> R <u> </u>	<u> </u>
2. Property Controlling in Section	S <u> </u> T <u> </u> R <u> </u>	<u> </u>
	S <u> </u> T <u> </u> R <u> </u>	<u> </u>
3. Miscellaneous Property in Sec.	S <u> </u> T <u> </u> R <u> </u>	<u> </u>
	S <u> </u> T <u> </u> R <u> </u>	<u> </u>

Vicki Popynski
CLERK/REGISTER
CHEBOYGAN COUNTY MICHIGAN

Register of Deeds Stamp & File Number

4. Lot No. _____, Recorded Plat _____

5. Private Claims _____


I, JAMES H. GRANGER, in a field survey on JULY 12, 19 99 do hereby state that under requirements of P.A. 74, Michigan P.A. of 1970, the corner points mentioned in lines 1 and 2 above were in conformance with regulations and rules therefore as required in the current manual of survey instructions of the United States Department of the Interior, Bureau of Land Management or by a decree of a Court of Law and for that the corner points mentioned in lines 3, 4 and 5 above were in conformance with the rules of the Michigan Board of Land Surveyors or by a Decree of a Court of Law; established, re-established, monumented, recovered, found as expressed below:

NOTE: Not more than 2 corners, all in the same town and range, may be recorded on this certificate.

A	B	C	D	E	F	G	H	I	J	K	L	M
1												
2	6		5		4		3		2		1	
3												
4	7		8		9		10		11		12	
5												
6	18		17		16		15		14		13	
7												
8	19		20		21		22		23		24	
9												
10	30		29		28		27		26		25	
11												
12	31		32		33		34		35		36	
13												

A. Description of original monument and accessories and/or subsequent restoration:

1855 GLO Resurvey Harvey Mellen	Set wood post	18" Elm 9" Maple	S31°E 7 lks S71°W 11 lks
1981 Unrecorded Survey Orlando Doyle #7319	indicates metal monument		
1998 Survey Neil Livasy #31611	Fd monument Set 4 witnesses		

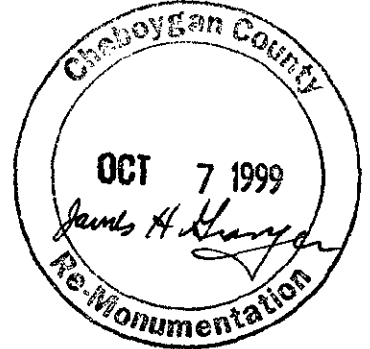

B. Description of corner evidence found and/or method applied in restoring or reestablishing corner:

Found 1" pipe and 4 witnesses per recorded survey. Neil Livasy #31611 did not record LCRC. Accepted position as established. Replaced 1" pipe with 5/8" rebar

SURVEY & RE-MONUMENTATION

MAR 03 2000

C. Description of monument for corner and accessories established to perpetuate locating the position of the corner:

5/8" rebar with Remonumentation Cap			
18" Maple	S83°W	31.53'	Ex nail
8" Maple	S 5°W	15.50'	Ex nail
8" Twin Oak	S40°E	24.50'	Ex nail
14" White Birch	S87°E	11.23'	Ex nail



Signed by James H. Granger
Surveyor's Michigan License No. 16041

Date November 12, 1999