

SURVEY & REMONUMENTATION
CHEBOYGAN COUNTY REMONUMENTATION CORNER

MAY 05 1997

LAND CORNER RECORDATION CERTIFICATE
Filing Requirement of Act 74, Mich. P.A. 1970

For corners in **CHEBOYGAN** **COMMISSION**
 (County)

Located In:

Corner Code #

- | | | |
|--------------------------------------|--------------------------|-------------|
| 1. Public Land Survey | T <u>37N</u> R <u>2W</u> | <u>C-12</u> |
| | T _____ R _____ | _____ |
| | T _____ R _____ | _____ |
| | T _____ R _____ | _____ |
| 2. Property Controlling in Section | S _____ T _____ R _____ | _____ |
| | S _____ T _____ R _____ | _____ |
| 3. Miscellaneous Property in Section | S _____ T _____ R _____ | _____ |
| | S _____ T _____ R _____ | _____ |
4. Lot No. _____, Recorded Plat _____
5. Private Claims _____

RECEIVED FOR RECORD

96 OCT -1 PM 4: 00

Joanna Sperry
 CLERK/REGISTER
 CHEBOYGAN COUNTY, MICHIGAN

Register of Deeds Stamp & File Number

	A	B	C	D	E	F	G	H	I	J	K	L	A
2	6		5		4		3		2		1		
3													
4	7		8		9		10		11		12		
5													
6	18		17		16		15		14		13		
7													
8	19		20		21		22		23		24		
9													
10	30		29		28		27		26		25		
11													
12	31		32		33		34		35		36		
13													

I, Ronald Bischer, in a field survey on September 3, 1996, do hereby certify that under requirements of P.A. 74, Michigan P.A. of 1970, the corner points mentioned in lines 1 and 2 above were in conformance with regulations and rules therefore as required in the current manual of survey instructions of the United States Department of the Interior, Bureau of Land Management or by a decree of a Court of Law and/or that the corner points mentioned in lines 3, 4 and 5 above were in conformance with the rules of the Michigan Board of Professional Surveyors or by a Decree of a Court of Law; established, re-established, monumented, re-monumented, recovered, found as expressed below:

NOTE: Not more than 4 corners, all in the same town and range, may be recorded on this certificate.


A. Description of original monument and accessories and/or subsequent restoration:

1855 Resurvey - Harvey Mellen
 Set Wood Post
 Beech 10" S17° W 15 lks
 Sugar 8" N63° W 16 lks



B. Description of corner evidence found and/or method applied in restoring or reestablishing corner:

Found 1/2" pinched pipe in centerline of trail in line with fences running east and west
 Replaced with Cheboygan County Remonumentation Monument

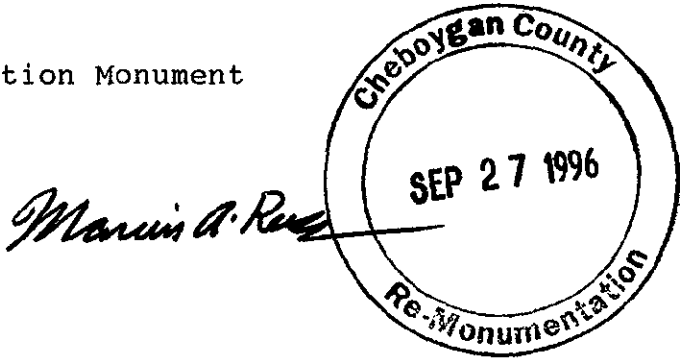

C. Description of monument for corner and accessories established to perpetuate locating the position of the corner:

Cheboygan County Remonumentation Monument
 N20° W 37.57' 8" Maple
 N34° E 40.72' 3" Maple
 N69° E 28.84' 4" Cherry
 West 33.00' 1/2" pipe

LIBER 010 PAGE 150

Signed by Ronald R. Bischer
 Surveyor's Michigan License No. 22428

Date Sept. 18, 1996