SURVEY & REMONUMENTATION
MAY 05 1997
COMMISSION

CHEBOYGAN COUNTY REMONUMENTATION CORNER

LAND CORNER RECORDATION CERTIFICATE
Filing Requirement of Act 74, Mich. P.A. 1970

For corners in CHEBOYGAN (County)

RECEIVED FOR RECORD
96 OCT -1 PM 4:01
CLERK/REGISTER
CHEBOYGAN COUNTY, MICHIGAN

Register of Deeds Stamp & File Number

	Located In:	Corner Code #
1. Public Land Survey	T 37N R 2W	C-13
	T ___ R ___	
	T ___ R ___	
	T ___ R ___	
2. Property Controlling	S ___ T ___ R ___	
in Section	S ___ T ___ R ___	
3. Miscellaneous	S ___ T ___ R ___	
Property in Section	S ___ T ___ R ___	

4. Lot No. _____, Recorded Plat _____
5. Private Claims _____

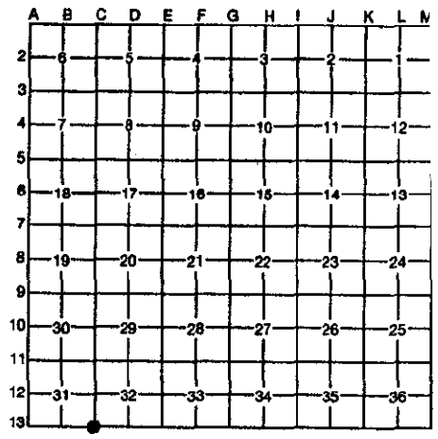

I, Ronald Bischer, in a field survey on September 3, 19 96, do hereby certify that under requirements of P.A. 74, Michigan P.A. of 1970, the corner points mentioned in lines 1 and 2 above were in conformance with regulations and rules therefore as required in the current manual of survey instructions of the United States Department of the Interior, Bureau of Land Management or by a decree of a Court of Law and/or that the corner points mentioned in lines 3, 4 and 5 above were in conformance with the rules of the Michigan Board of Professional Surveyors or by a Decree of a Court of Law; established, re-established, monumented, re-monumented, recovered, found as expressed below:

NOTE: Not more than 4 corners, all in the same town and range, may be recorded on this certificate.

A. Description of original monument and accessories and/or subsequent restoration:

1855 Resurvey - Harvey Mellen
Set Wood Post
Beech 9" N60° W 12 lks
Beech 7" N34° E 11 lks

STATE OF MICHIGAN
RONALD BISCHER LAND SURVEYOR NO. 22428
REGISTERED LAND SURVEYOR

B. Description of corner evidence found and/or method applied in restoring or reestablishing corner:

Found very old fence corner by computed location
Fence running East-west-south

Set Cheboygan County Remonumentation Monument
by Fence Corner

Cheboygan County
SEP 27 1996
Re-Monumentation

C. Description of monument for corner and accessories established to perpetuate locating the position of the corner:

Cheboygan County Remonumentation Monument

N50° E 53.94' 18" Oak
S56° E 2.95' 8" Maple
S51° W 27.82' 9" Maple
N39° W 65.97' 11" Maple

LIBER 010 PAGE 151

Signed by Ronald R. Bischer Date Sept. 18, 1996
Surveyor's Michigan License No. 22428

FORM APPROVED BY MICHIGAN STATE BOARD OF PROFESSIONAL SURVEYORS, JAN. 28, 1971
REVISED MAY 14, 1975
REVISED JAN., 1983