

CHEBOYGAN COUNTY REMONUMENTATION CORNER

LAND CORNER RECORDATION CERTIFICATE  
Filing Requirement of Act 74, Mich. P.A. 1970

For corners in

CHEBOYGAN  
(County)

Located In:

Corner Code #

1. Public Land Survey

T 37NR 2W

D-5

2. Property Controlling in Section

S T R

3. Miscellaneous Property in Sec.

S T R

4. Lot No. \_\_\_\_\_, Recorded Plat \_\_\_\_\_

5. Private Claims \_\_\_\_\_

RECEIVED FOR RECORD 12-18-97  
at 11:25 O'Clock A.M.

*James H. Granger*

CLERK/REGISTER  
CHEBOYGAN COUNTY, MICHIGAN

Register of Deeds Stamp & File Number

I, JAMES H. GRANGER, in a field survey on JULY 15, 1997 do hereby state that under requirements of P.A. 74, Michigan P.A. of 1970, the corner points mentioned in lines 1 and 2 above were in conformance with regulations and rules therefore as required in the current manual of survey instructions of the United States Department of the Interior, Bureau of Land Management or by a decree of a Court of Law and for that the corner points mentioned in lines 3, 4 and 5 above were in conformance with the rules of the Michigan Board of Land Surveyors or by a Decree of a Court of Law; established, re-established, monumented, recovered, found as expressed below:

NOTE: Not more than 2 corners, all in the same town and range, may be recorded on this certificate.

A. Description of original monument and accessories and/or subsequent restoration:

D-5 1855 Original Survey Set wood post 9" Tamarack N 2°30'W 1.74 lks  
Harvey Mellen 12" Tamarack N10°30'W 1.90 lks

SURVEY & REMONUMENTATION

FEB 26 1998

SECTION

A	B	C	D	E	F	G	H	I	J	K	L	M
1												
2	6	5	4	3	2	1						
3												
4	7	8	9	10	11	12						
5												
6	18	17	16	15	14	13						
7												
8	19	20	21	22	23	24						
9												
10	30	29	28	27	26	25						
11												
12	31	32	33	34	35	36						
13												



B. Description of corner evidence found and/or method applied in restoring or reestablishing corner:


D-5 No evidence found. Corner falls in 2' of water in swamp. Set 5/8" rebar and remonumentation cap Reference corners on South and N-S 1/4 lines of Section 8.

C. Description of monument for corner and accessories established to perpetuate locating the position of the corner:

D-5 Reference Corner	Reference Corner
5/8" rebar and remonumentation cap	5/8" rebar and remonumentation cap
511.00' East of D-5 on South Section line	229.00' North of D-5 on N-S 1/4 line
12" Poplar S83°W 7.22' Set tag #16041	12" Poplar N19°W 10.73' Set tag #16041
4" Pine S14°W 12.56' Set tag #16041	4" Oak S59°W 20.19' Set tag #16041
4" Poplar S28°E 12.33' Set tag #16041	5" Oak S22°W 14.75' Set tag #16041
14" Poplar N32°E 30.72' Set tag #16041	4" Pine S49°E 12.64' Set tag #16041

Signed by James H. Granger  
License No. 16041

Date Nov. 17, 1997 Surveyor's Michigan

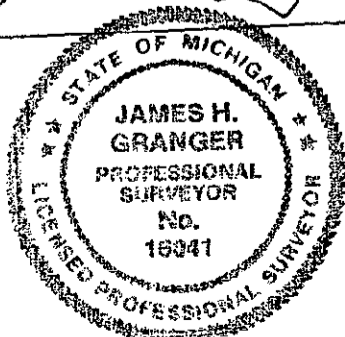

FORM APPROVED BY MICHIGAN STATE BOARD OF PROFESSIONAL SURVEYORS, JAN. 28, 1971  
REVISED 11, 1975

REVISED JAN. 1983  
REVISED OCT., 1986