CHEP 'GAN COUNTY I 'UMENTATION C RNER

LAND CORNER RECORDATION CERTIFICATE
Filing Requirement of Act 74, Mich. P.A. 1970

RECEIVED
FOR RECORD

99 DEC -6 PM 2:59

Vicky Dyzgymski
CLERK/REGISTER
CHEBOYGAN COUNTY MICHIGAN

Register of Deeds Stamp & File Number

For corners in

CHEBOYGAN (County) Located In: Corner Code #

1. *Public Land Survey*		T 37N	R 2W	E-4
		T___	R___	
		T___	R___	
		T___	R___	
2. *Property Controlling*	S___	T___	R___	
in Section	S___	T___	R___	
3. *Miscellaneous*	S___	T___	R___	
Property in Sec.	S___	T___	R___	

4. Lot No. _____ , Recorded Plat _____

5. Private Claims _____

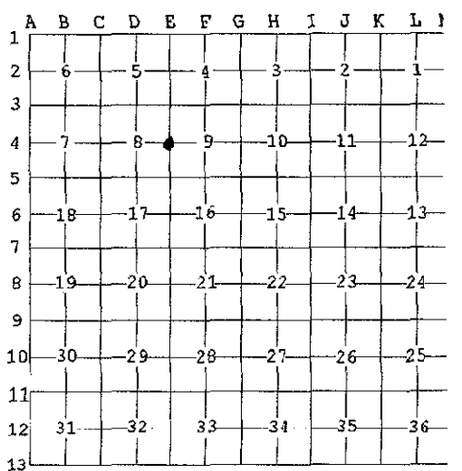

I, JAMES H. GRANGER, in a field survey on JULY 12, 19 99 do hereby state that under requirements of P.A. 74, Michigan P.A. of 1970, the corner points mentioned in lines 1 and 2 above were in conformance with regulations and rules therefore as required in the current manual of survey instructions of the United States Department of the Interior, Bureau of Land Management or by a decree of a Court of Law and /or that the corner points mentioned in lines 3, 4 and 5 above were in conformance with the rules of the Michigan Board of Land Surveyors or by a Decree of a Court of Law; established, re-established, monumented, recovered, found as expressed below:

NOTE: *Not more than 2 corners, all in the same town and range, may be recorded on this certificate.*

A. Description of original monument and accessories and/or subsequent restoration:

1855 GLO Resurvey Harvey Mellen	Set wood post	14" Tamarack 8" Cedar	S39°E N20°W	15 lks 8 lks
1974 Survey Orlando Doyle #7319	indicates corner no witnesses			
1974 LCRC	1" pipe and 3 witnesses			

Cheboygan County
OCT 7 1999
James H Granger
Re-Monumentation

B. Description of corner evidence found and/or method applied in restoring or reestablishing corner:

Found 1" pipe and 2 overgrown witnesses per LCRC. Accepted position as established. Replaced 1" pipe with 5/8" rebar.

C. Description of monument for corner and accessories established to perpetuate locating the position of the corner:

5/8" rebar with Remonumentation Cap

4" Cedar	N47°E	4.35'	Nail & tag #16041
6" Cedar	N64°W	19.58'	nail & tag #16041
4" Cedar	S77°W	15.83'	nail & tag #16041
9" Poplar	S20°E	3.63'	Nail & tag #16041

STATE OF MICHIGAN
JAMES H. GRANGER
PROFESSIONAL SURVEYOR
No. 16041
LICENSED PROFESSIONAL SURVEYOR

Signed by James H Granger Date November 12, 1999

Surveyor's Michigan License No. 16041

SURVEY &
RE MONUMENTATION
MAR 03 2000
SECTION

FORM APPROVED BY MICHIGAN STATE BOARD OF PROFESSIONAL SURVEYORS, JAN. 28, 1971
REVISED 14,197
REVISED JAN., 199
REVISED OCT., 199

LIBER 011 PAGE 144