

CHEBOYGAN COUNTY REMONUMENTATION CORNER

LAND CORNER RECORDATION CERTIFICATE
Filing Requirement of Act 74, Mich. P.A. 1970

RECEIVED
FOR RECORD

99 DEC -6 PM 3: 00

For corners in

CHEBOYGAN (County)	Located In:	Corner Code #
1. Public Land Survey	T 37NR 2W	E-7
	T R	
	T R	
	T R	
2. Property Controlling in Section	S T R	
	S T R	
3. Miscellaneous Property in Sec.	S T R	
	S T R	

W. J. Pappas
CLERK/REGISTER
CHEBOYGAN COUNTY MICHIGAN

Register of Deeds Stamp & File Number

4. Lot No. _____, Recorded Plat _____

5. Private Claims _____


I, JAMES H. GRANGER, in a field survey on JULY 9, 1999 do hereby state that under requirements of P.A. 74, Michigan P.A. of 1970, the corner points mentioned in lines 1 and 2 above were in conformance with regulations and rules therefore as required in the current manual of survey instructions of the United States Department of the Interior, Bureau of Land Management or by a decree of a Court of Law and /or that the corner points mentioned in lines 3, 4 and 5 above were in conformance with the rules of the Michigan Board of Land Surveyors or by a Decree of a Court of Law; established, re-established, monumented, recovered, found as expressed below:

1	A	B	C	D	E	F	G	H	I	J	K	L	M
2		6		5		4		3		2		1	
3													
4		7		8		9		10		11		12	
5													
6		18		17		16		15		14		13	
7													
8		19		20		21		22		23		24	
9													
10		30		29		28		27		26		25	
11													
12		31		32		33		34		35		36	
13													

NOTE: Not more than 2 corners, all in the same town and range, may be recorded on this certificate.

A. Description of original monument and accessories and/or subsequent restoration:

1855 GLO Resurvey Harvey Mellen	Set wood post	16" Sugar 12" Beech	N50°W S57°E	57 lks 4 lks
1960-1970 Unrecorded Survey Orlando Doyle #7319	indicates metal monument no witnesses			
1972 Unrecorded Survey Orlando Doyle #7319	indicates iron pipe no witnesses			
1988 Unrecorded Survey	indicates metal monument found no witnesses			

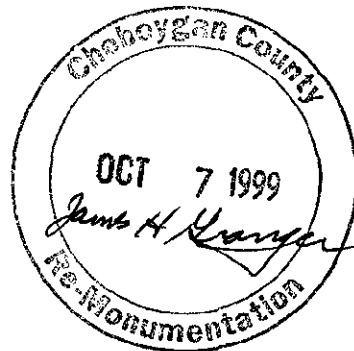


B. Description of corner evidence found and/or method applied in restoring or reestablishing corner:

Found 1" pipe below road surface. Accepted position as established. Installed 5/8" rebar inside 1" pipe.
Found witness tag Ron Bischer #22428. No LCRC recorded.

C. Description of monument for corner and accessories established to perpetuate locating the position of the corner:

5/8" rebar with Remonumentation Cap inside 1" pipe			
5' Elm	N21°E	77.82'	Fd Nail & tag #22428
4" Elm	N 6°E	98.16'	Nail & tag #16041
4" Elm	N44°W	46.50'	Nail & tag #16041
Fence Post	S56°E	81.36'	Nail & tag #16041

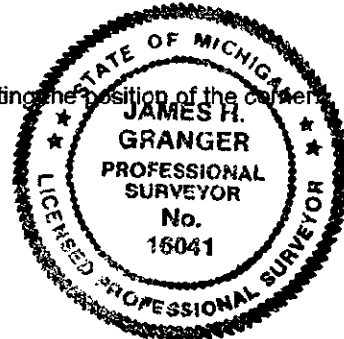

Signed by James H. Granger
Surveyor's Michigan License No. 16041

Date November 12, 1999

SURVEY &
RE-MONUMENTATION

FORM APPROVED BY MICHIGAN STATE BOARD OF PROFESSIONAL SURVEYORS, JAN. 28, 1971

REVISED 14, 1975
REVISED JAN., 1983
REVISED OCT., 1995

MAR 03 2000

LIBER 011 PAGE 145

SECTION