

CHEBOYGAN COUNTY REMONUMENTATION CORNER

LAND CORNER RECORDATION CERTIFICATE
Filing Requirement of Act 74, Mich. P.A. 1970

RECEIVED
FOR RECORD

99 DEC -6 PM 3: 14

For corners in

<u>CHEBOYGAN</u> (County)	Located In:	Corner Code #
1. Public Land Survey	T 37NR 2W	E-11
	T R	
	T R	
	T R	
2. Property Controlling in Section	S T R	
	S T R	
3. Miscellaneous Property in Sec.	S T R	
	S T R	

Wichy Pyrzyński
CLERK/REGISTER
CHEBOYGAN COUNTY MICHIGAN

Register of Deeds Stamp & File Number

4. Lot No. _____, Recorded Plat _____

5. Private Claims _____


I, JAMES H. GRANGER, in a field survey on JULY 12, 1999 do hereby state that under requirements of P.A. 74, Michigan P.A. of 1970, the corner points mentioned in lines 1 and 2 above were in conformance with regulations and rules therefore as required in the current manual of survey instructions of the United States Department of the Interior, Bureau of Land Management or by a decree of a Court of Law and for that the corner points mentioned in lines 3, 4 and 5 above were in conformance with the rules of the Michigan Board of Land Surveyors or by a Decree of a Court of Law; established, re-established, monumented, recovered, found as expressed below:

NOTE: Not more than 2 corners, all in the same town and range, may be recorded on this certificate.

1	A	B	C	D	E	F	G	H	I	J	K	L	D
2		6		5		4		3		2		1	
3													
4		7		8		9		10		11		12	
5													
6		18		17		16		15		14		13	
7													
8		19		20		21		22		23		24	
9													
10		30		29		28		27		26		25	
11													
12		31		32		33		34		35		36	
13													

A. Description of original monument and accessories and/or subsequent restoration:

1855 GLO Resurvey Harvey Mellen	Set wood post	10" Sugar 14" Beech	N39°W N60°E	14 lks 13 lks
1964 LCRC Orlando Doyle #7319	Set 1" pipe set 3 witnesses			
1977 LCRC Orlando Doyle #7319	Fd 1" pipe set 3 witnesses			
1983 LCRC Ronald Bischer #22428	Fd railroad spike set 3 witnesses			

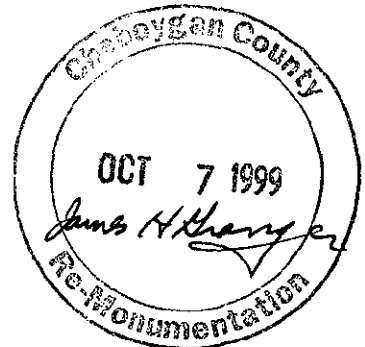


B. Description of corner evidence found and/or method applied in restoring or reestablishing corner:

Found railroad spike and 1 witness per LCRC Accepted position as established. Replaced spike with 5/8" rebar

C. Description of monument for corner and accessories established to perpetuate location of the corner:

5/8" rebar with Remonumentation Cap			
Abandoned PP	N29°E	66.57'	Fd nail & washer
Fence post	S49°E	73.56'	nail & tag #16041
3" Ash	N69°E	94.74'	nail & tag #16041
10" Ash	N20°W	38.10'	Nail & tag #16041

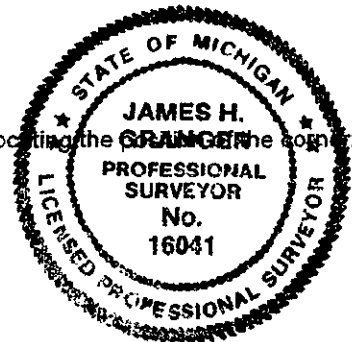

Signed by James H. Granger
Surveyor's Michigan License No. 16041

Date November 12, 1999

RECORDED

MAR 03 2000

SECTION

LIBER 011 PAGE 157