

CHEBOYGAN COUNTY REMONUMENTATION CORNER

LAND CORNER RECORDATION CERTIFICATE  
Filing Requirement of Act 74, Mich. P.A. 1970

For corners in

CHEBOYGAN Located In: Corner Code #  
(County)

1. Public Land Survey 38N 2W F-13  
T 37NR 2W F-1  
T \_\_\_ R \_\_\_  
T \_\_\_ R \_\_\_  
T \_\_\_ R \_\_\_  
T \_\_\_ R \_\_\_

2. Property Controlling in Section S \_\_\_ T \_\_\_ R \_\_\_  
S \_\_\_ T \_\_\_ R \_\_\_

3. Miscellaneous Property in Sec. S \_\_\_ T \_\_\_ R \_\_\_  
S \_\_\_ T \_\_\_ R \_\_\_

RECEIVED FOR RECORD 12-18-97  
at 11:29 O'Clock A M

*Joanne Spray*

CLERK/REGISTER  
CHEBOYGAN COUNTY, MICHIGAN

Register of Deeds Stamp & File Number

4. Lot No. \_\_\_\_\_, Recorded Plat \_\_\_\_\_  
5. Private Claims \_\_\_\_\_

I, JAMES H. GRANGER, in a field survey on JULY 15, 19 97 do hereby state that under requirements of P.A. 74, Michigan P.A. of 1970, the corner points mentioned in lines 1 and 2 above were in conformance with regulations and rules therefore as required in the current manual of survey instructions of the United States Department of the Interior, Bureau of Land Management or by a decree of a Court of Law and /or that the corner points mentioned in lines 3, 4 and 5 above were in conformance with the rules of the Michigan Board of Land Surveyors or by a Decree of a Court of Law; established, re-established, monumented, recovered, found as expressed below.

NOTE: Not more than 2 corners, all in the same town and range, may be recorded on this certificate.

A. Description of original monument and accessories and/or subsequent restoration:

F-1 1840 Original Survey Set wood post 10" Cedar N38°W 23 lks  
John Mullett 8" Cedar N56°E 12 lks


1955 Survey 3/4" pipe  
Orlando Doyle #7319

SURVEY & REMONUMENTATION

FEB 26 1998

SECTION

	A	B	C	D	E	F	G	H	I	J	K	L	M
1													
2	6			5		4		3		2		1	
3													
4	7			8		9		10		11		12	
5													
6	18			17		16		15		14		13	
7													
8	19			20		21		22		23		24	
9													
10	30			29		28		27		26		25	
11													
12	31			32		33		34		35		36	
13													

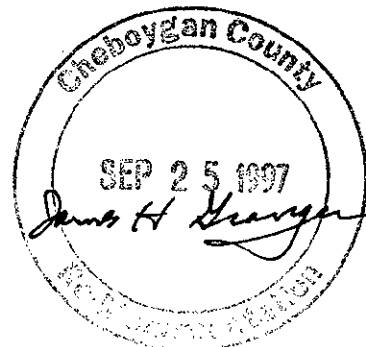

B. Description of corner evidence found and/or method applied in restoring or reestablishing corner:

F-1 Found 3/4" pipe at corner position. Replaced with 5/8" rebar and remonumentation cap.


C. Description of monument for corner and accessories established to perpetuate locating the position of the corner:

F-1 5/8" rebar and Remonumentation Cap  
4" Cedar S 4°E 18.86' Set tag #16041  
14" Poplar S37°W 24.25' Set tag #16041  
4" Poplar N79°W 38.50' Set tag #16041  
4" Maple N37°E 17.04' Set tag #16041

Signed by James H. Granger

Date Nov 17, 1997 Surveyor's Michigan

License No. 16041

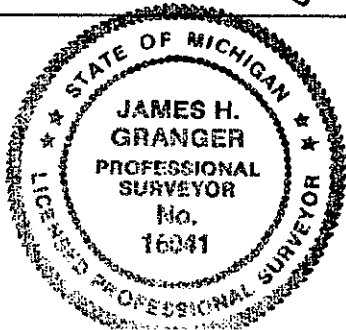

FORM APPROVED BY MICHIGAN STATE BOARD OF PROFESSIONAL SURVEYORS, JAN. 28, 1971  
REVISED 14, 1976

REVISED JAN., 1983  
REVISED OCT., 1996