

**CHEBOYGAN COUNTY REMONUMENTATION CORNER**

**LAND CORNER RECORDATION CERTIFICATE**  
 Filing Requirement of Act 74, Mich. P.A. 1970

For corners in

<u>CHEBOYGAN</u> (County)	Located In:	Corner Code #
1. Public Land Survey	T <u>37NR 2W</u>	<u>F-3</u>
	T ___ R ___	_____
	T ___ R ___	_____
	T ___ R ___	_____
2. Property Controlling in Section	S ___ T ___ R ___	_____
	S ___ T ___ R ___	_____
3. Miscellaneous Property in Sec.	S ___ T ___ R ___	_____
	S ___ T ___ R ___	_____

RECEIVED FOR RECORD 12-18-97  
 at 11:30 O'Clock A M

*Joanne Spray*

CLERK/REGISTER  
 CHEBOYGAN COUNTY, MICHIGAN

Register of Deeds Stamp & File Number

-4. Lot No. \_\_\_\_\_, Recorded Plat \_\_\_\_\_  
 -5. Private Claims \_\_\_\_\_

I, JAMES H. GRANGER, in a field survey on JULY 15, 19 97 do hereby state that under requirements of P.A. 74, Michigan P.A. of 1970, the corner points mentioned in lines 1 and 2 above were in conformance with regulations and rules therefore as required in the current manual of survey instructions of the United States Department of the Interior, Bureau of Land Management or by a decree of a Court of Law and /or that the corner points mentioned in lines 3, 4 and 5 above were in conformance with the rules of the Michigan Board of Land Surveyors or by a Decree of a Court of Law, established, re-established, monumented, recovered, found as expressed below:

	A	B	C	D	E	F	G	H	I	J	K	L	M
1													
2	6		5		4		3		2		1		
3													
4	7		8		9		10		11		12		
5													
6	18		17		16		15		14		13		
7													
8	19		20		21		22		23		24		
9													
10	30		29		28		27		26		25		
11													
12	31		32		33		34		35		36		
13													

NOTE: Not more than 2 corners, all in the same town and range, may be recorded on this certificate.

a. Description of original monument and accessories and/or subsequent restoration:


-3 1855 Original Survey Set wood post 10" Cedar N55°E 12 lks  
 John Mullett 10" Sugar S62°W 12 lks

1974 LCRC 1" pipe  
 Orlando Doyle #7319

**SURVEY & REMONUMENTATION**

FEB 26 1998

SECTION

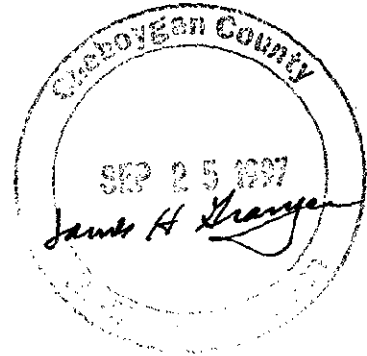

- Description of corner evidence found and/or method applied in restoring or reestablishing corner:


-3 No evidence found. Set 5/8" rebar and remonumentation cap using Section information from Doyle Civil Engineers.

Description of monument for corner and accessories established to perpetuate locating the position of the corner:

3 5/8" rebar and Remonumentation Cap  
 14" Poplar N 5°W 16.96' Set tag #16041  
 5" Poplar S36°W 21.98' Set tag #16041  
 5" Poplar S42°E 32.06' Set tag #16041  
 4" Poplar S74°W 54.58' Set tag #16041

signed by James H. Granger  
 License No. 16041

Date Nov. 17, 1997 Surveyor's Michigan

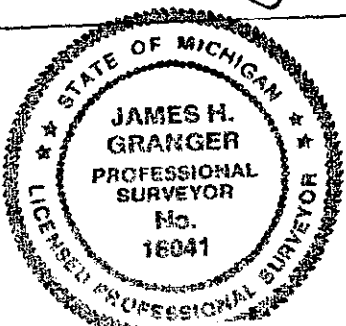

FORM APPROVED BY MICHIGAN STATE BOARD OF PROFESSIONAL SURVEYORS, JAN. 28, 1971  
 REVISED 14, 1976

REVISED JAN., 1983  
 REVISED OCT., 1985