

CHEBOYGAN COUNTY REMONUMENTATION CORNER

LAND CORNER RECORDATION CERTIFICATE  
Filing Requirement of Act 74, Mich. P.A. 1970

For corners in

CHEBOYGAN Located In: Corner Code #  
(County)

1. Public Land Survey T 37NR 2W F-5  
T \_\_\_ R \_\_\_  
T \_\_\_ R \_\_\_  
T \_\_\_ R \_\_\_

2. Property Controlling S \_\_\_ T \_\_\_ R \_\_\_  
in Section S \_\_\_ T \_\_\_ R \_\_\_

3. Miscellaneous S \_\_\_ T \_\_\_ R \_\_\_  
Property in Sec. S \_\_\_ T \_\_\_ R \_\_\_

RECEIVED FOR RECORD 12-6-99  
at 3:24 O'Clock P. M  
*Debbie Spyzynski*  
CLERK/REGISTER  
CHEBOYGAN COUNTY, MICHIGAN

Register of Deeds Stamp & File Number

4. Lot No. \_\_\_\_\_, Recorded Plat \_\_\_\_\_  
5. Private Claims \_\_\_\_\_

I, JAMES H. GRANGER, in a field survey on JULY 12, 19 99 do hereby state that under requirements of P.A. 74, Michigan P.A. of 1970, the corner points mentioned in lines 1 and 2 above were in conformance with regulations and rules therefore as required in the current manual of survey instructions of the United States Department of the Interior, Bureau of Land Management or by a decree of a Court of Law and for that the corner points mentioned in lines 3, 4 and 5 above were in conformance with the rules of the Michigan Board of Land Surveyors or by a Decree of a Court of Law; established, re-established, monumented, recovered, found as expressed below:

NOTE: Not more than 2 corners, all in the same town and range, may be recorded on this certificate.


	A	B	C	D	E	F	G	H	I	J	K	L
1												
2	6		5		4		3		2		1	
3												
4	7		8		9		10		11		12	
5												
6	18		17		16		15		14		13	
7												
8	19		20		21		22		23		24	
9												
10	30		29		28		27		26		25	
11												
12	31		32		33		34		35		36	
13												

A. Description of original monument and accessories and/or subsequent restoration:

1855 GLO Resurvey Set wood post 12" Cedar N43°E 6 lks  
Harvey Mellen 12" Hemlock N47°W 19 lks

1962 Unrecorded Survey indicates metal monument  
Orlando Doyle #7319

1980 Unrecorded Survey indicates metal monument  
Orlando Doyle #7319

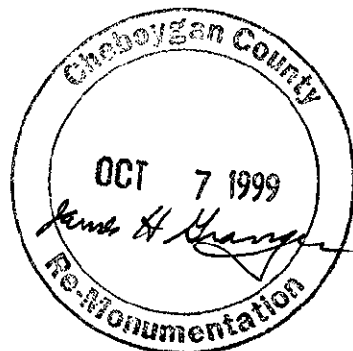


B. Description of corner evidence found and/or method applied in restoring or reestablishing corner:

Found 1 1/2" pipe and 4 witness tags of Ron Bischer #22428. No LCRC recorded by either Doyle nor Bischer. Accepted position as established. Placed 5/8" rebar inside pipe.

C. Description of monument for corner and accessories established to perpetuate locating the position of the corner:

5/8" rebar with Remonumentation Cap inside 1 1/2" pipe  
Power Pole N20°E 33.77' Fd tag #22428  
8" Maple Clump S65°W 38.58' Fd tag #22428  
Fence corner S14°W 32.42' Fd tag #22428  
32" Pine S43°E 39.86' Fd tag #22428

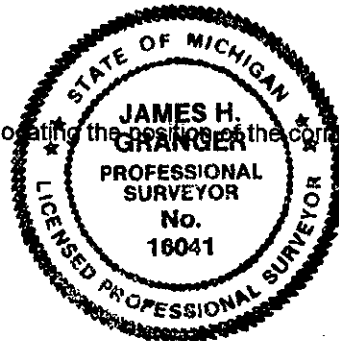

Signed by James H. Granger  
Surveyor's Michigan License No. 16041

Date November 12, 1999

MAR 03 2000

SECTION