

CHEBOYGAN COUNTY REMONUMENTATION CORNER

LAND CORNER RECORDATION CERTIFICATE
Filing Requirement of Act 74, Mich. P.A. 1970

For corners in

<u>CHEBOYGAN</u> (County)	Located In:	Corner Code #
	38W 2W	G-13
1. Public Land Survey	T 37NR 2W	G-1
	T ___ R ___	_____
	T ___ R ___	_____
	T ___ R ___	_____
2. Property Controlling in Section	S ___ T ___ R ___	_____
	S ___ T ___ R ___	_____
3. Miscellaneous Property in Sec.	S ___ T ___ R ___	_____
	S ___ T ___ R ___	_____

RECEIVED FOR RECORD 12-18-97
at 11:31 O'Clock AM

Joanne Spray

CLERK/REGISTER
CHEBOYGAN COUNTY, MICHIGAN

Register of Deeds Stamp & File Number

4. Lot No. _____, Recorded Plat _____
5. Private Claims _____

I, JAMES H. GRANGER, in a field survey on JULY 15, 19 97 do hereby state that under requirements of P.A. 74, Michigan P.A. of 1970, the corner points mentioned in lines 1 and 2 above were in conformance with regulations and rules therefore as required in the current manual of survey instructions of the United States Department of the Interior, Bureau of Land Management or by a decree of a Court of Law and for that the corner points mentioned in lines 3, 4 and 5 above were in conformance with the rules of the Michigan Board of Land Surveyors or by a Decree of a Court of Law; established, re-established, monumented, recovered, found as expressed below:

NOTE: Not more than 2 corners, all in the same town and range, may be recorded on this certificate.

A. Description of original monument and accessories and/or subsequent restoration:


G-1 1840 Original Survey	Set wood post	10" Spruce	N63°W	27 lks
John Mullett		10" Tamarack	N18°E	11 lks

SURVEY & REMONUMENTATION

FEB 26 1998

SECTION

A	B	C	D	E	F	G	H	I	J	K	L	M
2	6		5		4		3		2		1	
3												
4	7		8		9		10		11		12	
5												
6	18		17		16		15		14		13	
7												
8	19		20		21		22		23		24	
9												
10	30		29		28		27		26		25	
11												
12	31		32		33		34		35		36	
13												

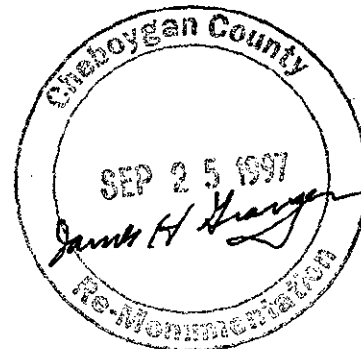

B. Description of corner evidence found and/or method applied in restoring or reestablishing corner:


G-1 No evidence found. Set 5/8" rebar and remonumentation cap using Section information from Doyle Civil Engineers.

C. Description of monument for corner and accessories established to perpetuate locating the position of the corner:

G-1 5/8" rebar and Remonumentation Cap
 4" Apple N67°W 73.54' Set tag #16041
 3" Apple S71°E 117.54' Set tag #16041
 Fence post N55°E 45.28' Set tag #16041
 Fence corner N 2°E 35.01' Set tag #16041

Signed by James H. Granger
License No. 16041

Date Nov. 17, 1997 Surveyor's Michigan

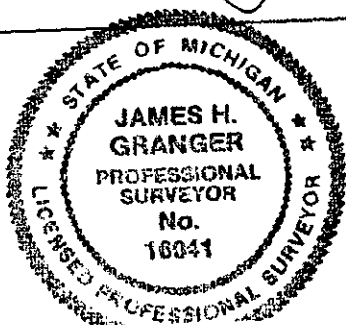

FORM APPROVED BY MICHIGAN STATE BOARD OF PROFESSIONAL SURVEYORS, JAN. 25, 1971
REVISED 14, 1976

REVISED JAN., 1963
REVISED OCT., 1966