

CHEBOYGAN COUNTY REMONUMENTATION CORNER

LAND CORNER RECORDATION CERTIFICATE
Filing Requirement of Act 74, Mich. P.A. 1970

For corners in

CHEBOYGAN Located In: Corner Code #
(County)

1. Public Land Survey T 37NR 2W G-3
T ___ R ___
T ___ R ___
T ___ R ___

2. Property Controlling S ___ T ___ R ___
in Section S ___ T ___ R ___

3. Miscellaneous S ___ T ___ R ___
Property in Sec. S ___ T ___ R ___

RECEIVED FOR RECORD 12-18-97
at 11:32 O'Clock A M

James Spray

CLERK/REGISTER
CHEBOYGAN COUNTY, MICHIGAN

Register of Deeds Stamp & File Number

4. Lot No. _____, Recorded Plat _____
5. Private Claims _____

I, JAMES H. GRANGER, in a field survey on JULY 15, 19 97, do hereby state that under requirements of P.A. 74, Michigan P.A. of 1970, the corner points mentioned in lines 1 and 2 above were in conformance with regulations and rules therefore as required in the current manual of survey instructions of the United States Department of the Interior, Bureau of Land Management or by a decree of a Court of Law and/or that the corner points mentioned in lines 3, 4 and 5 above were in conformance with the rules of the Michigan Board of Land Surveyors or by a Decree of a Court of Law; established, re-established, monumented, recovered, found as expressed below:

NOTE: Not more than 2 corners, all in the same town and range, may be recorded on this certificate.

A. Description of original monument and accessories and/or subsequent restoration:

G-3 1855 Original Survey Set wood post 14" W. Pine N18°W 54 lks
Harvey Mellen 12" Tamarack S16°E 43 lks

1974 LCRC 1" pipe
Orlando Doyle #7319

SURVEY &
REMONUMENTATION
FEB 26 1998
SECTION

1	A	B	C	D	E	F	G	H	I	J	K	L	M
2		6		5		4		3		2		1	
3													
4		7		8		9		10		11		12	
5													
6		18		17		16		15		14		13	
7													
8		19		20		21		22		23		24	
9													
10		30		29		28		27		26		25	
11													
12		31		32		33		34		35		36	
13													



B. Description of corner evidence found and/or method applied in restoring or reestablishing corner:


G-3 Found 1/2" iron and 2 witnesses from Doyle LCRC. Replaced with 5/8" rebar and remonumentation cap per existing witnesses.

C. Description of monument for corner and accessories established to perpetuate locating the position of the corner:

G-3 5/8" rebar and Remonumentation Cap
Twin 12" Birch N15°W 82.55' Fd nail and washer
10" Cedar N50°W 49.40' Fd nail and washer
5" Cedar N33°E 27.33' Set tag #16041
Fence post S24°W 34.66' Fd tag #22428

Signed by James H. Granger
License No. 16041

Date Nov. 17, 1997 Surveyor's Michigan

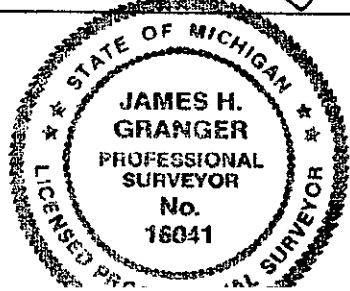

FORM APPROVED BY MICHIGAN STATE BOARD OF PROFESSIONAL SURVEYORS, JAN. 28, 1971
REVISED 14, 1976

REVISED JAN., 1983
REVISED OCT., 1996

LIBER 011 PAGE 36