

CHEBOYGAN COUNTY REMONUMENTATION CORNER

RECEIVED FOR RECORD

LAND CORNER RECORDATION CERTIFICATE
Filing Requirement of Act 74, Mich. P.A. 1970

99 DEC -6 PM 3: 02

For corners in

CHEBOYGAN Located In: Corner Code #
(County)

- 1. Public Land Survey T37N R 2W G-4
T R
T R
T R
- 2. Property Controlling in Section S T R
S T R
- 3. Miscellaneous Property in Sec. S T R
S T R

Cheryl Pyszynski
CLERK/REGISTER
CHEBOYGAN COUNTY MICHIGAN

Register of Deeds Stamp & File Number

4. Lot No. _____, Recorded Plat _____

5. Private Claims _____


A	B	C	D	E	F	G	H	I	J	K	L
1											
2	6		5		4		3		2		1
3											
4	7		8		9	●	10		11		12
5											
6	18		17		16		15		14		13
7											
8	19		20		21		22		23		24
9											
10	30		29		28		27		26		25
11											
12	31		32		33		34		35		36
13											

I, JAMES H. GRANGER, in a field survey on JULY 12, 19 99 do hereby state that under requirements of P.A. 74, Michigan P.A. of 1970, the corner points mentioned in lines 1 and 2 above were in conformance with regulations and rules therefore as required in the current manual of survey instructions of the United States Department of the Interior, Bureau of Land Management or by a decree of a Court of Law and /or that the corner points mentioned in lines 3, 4 and 5 above were in conformance with the rules of the Michigan Board of Land Surveyors or by a Decree of a Court of Law; established, re-established, monumented, recovered, found as expressed below:

NOTE: Not more than 2 corners, all in the same town and range, may be recorded on this certificate.

A. Description of original monument and accessories and/or subsequent restoration:

1855 GLO Resurvey Set wood post 9" Cedar S73°E 7 lks
Harvey Mellen 9" Cedar S511/2°W 19 lks

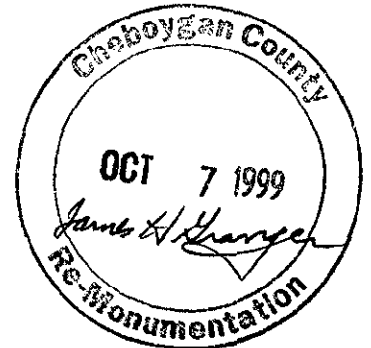


B. Description of corner evidence found and/or method applied in restoring or reestablishing corner:

No original evidence found. Found 1" pipe with cap #10695, Ken Larsen. No LCRC recorded. 1" pipe fits well with single proportionate measurement between G-3 and G-5. Accepted position as established. Replaced 1" pipe with 5/8" rebar.

C. Description of monument for corner and accessories established to perpetuate location of the corner:

- 5/8" rebar with Remonumentation Cap
- 3" Balsam N14°E 37.55' nail & tag #16041
- 10" Birch S34°W 46.14' nail & tag #16041
- 8" Cedar S29°W 42.58' nail & tag #16041
- Fence Post N81°E 8.58' nail & tag #16041

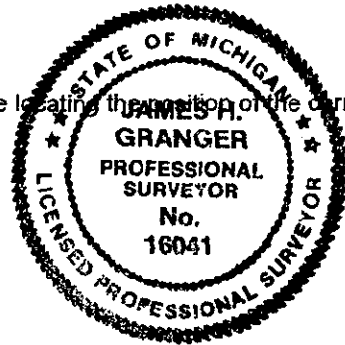

Signed by James H. Granger
Surveyor's Michigan License No. 16041

Date November 12, 1999

RF

MAR 03 2000

SECTION