

**CHEBOYGAN COUNTY REMONUMENTATION CORNER**

**LAND CORNER RECORDATION CERTIFICATE**  
 Filing Requirement of Act 74, Mich. P.A. 1970

For corners in

CHEBOYGAN Located In: Corner Code #  
 (County)

1. Public Land Survey T 37NR 2W G-5  
 T \_\_\_ R \_\_\_  
 T \_\_\_ R \_\_\_  
 T \_\_\_ R \_\_\_  
 T \_\_\_ R \_\_\_

2. Property Controlling S \_\_\_ T \_\_\_ R \_\_\_  
 in Section S \_\_\_ T \_\_\_ R \_\_\_

3. Miscellaneous S \_\_\_ T \_\_\_ R \_\_\_  
 Property in Sec. S \_\_\_ T \_\_\_ R \_\_\_

RECEIVED FOR RECORD 12-18-97  
 at 11:33 O'Clock A M

*Joanne Spray*

CLERK/REGISTER  
 CHEBOYGAN COUNTY, MICHIGAN

Register of Deeds Stamp & File Number

4. Lot No. \_\_\_\_\_, Recorded Plat \_\_\_\_\_  
 5. Private Claims \_\_\_\_\_

I, JAMES H. GRANGER, in a field survey on JULY 15, 19 97 do hereby state that under requirements of P.A. 74, Michigan P.A. of 1970, the corner points mentioned in lines 1 and 2 above were in conformance with regulations and rules therefore as required in the current manual of survey instructions of the United States Department of the Interior, Bureau of Land Management or by a decree of a Court of Law and for that the corner points mentioned in lines 3, 4 and 5 above were in conformance with the rules of the Michigan Board of Land Surveyors or by a Decree of a Court of Law, established, re-established, monumented, recovered, found as expressed below:

NOTE: Not more than 2 corners, all in the same town and range, may be recorded on this certificate.

A. Description of original monument and accessories and/or subsequent restoration:

- 3-5 1855 Original Survey Set wood post 12" Ash S60°E 12 lks  
 Harvey Mellen 10" Cedar N58°W 20 lks
- 1971 Survey Corner shown  
 Orlando Doyle #7319
- 1997 Survey Railroad spike  
 James H. Granger #16041

**SURVEY &  
 REMONUMENTATION**  
 FEB 26 1998  
 SECTION

	A	B	C	D	E	F	G	H	I	J	K	L	M
1													
2		6		5		4		3		2		1	
3													
4		7		8		9		10		11		12	
5													
6		18		17		16		15		14		13	
7													
8		19		20		21		22		23		24	
9													
10		30		29		28		27		26		25	
11													
12		31		32		33		34		35		36	
13													



B. Description of corner evidence found and/or method applied in restoring or reestablishing corner:


- 3-5 Found railroad spike. Fits well with Section information from Doyle Civil Engineers. Replaced with 5/8" rebar and remonumentation cap.

C. Description of monument for corner and accessories established to perpetuate locating the position of the corner:

- 3-5 5/8" rebar and Remonumentation Cap
- 8" Birch N80°W 115.54' Set tag #16041
- 4" Maple S79°W 64.28' Set tag #16041
- 4" Balsam S54°E 43.24' Set tag #16041
- 3" Ash N17°E 18.10' Set tag #16041

Signed by James H. Granger  
 License No. 16041

Date Nov. 17, 1997 Surveyor's Michigan

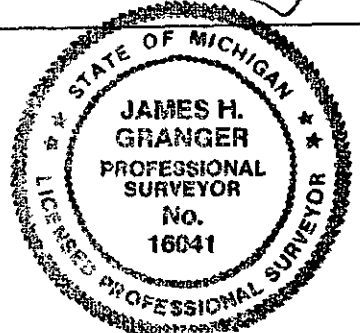

FORM APPROVED BY MICHIGAN STATE BOARD OF PROFESSIONAL SURVEYORS, JAN. 28, 1971  
 REVISED 14, 1976

REVISED JAN., 1983  
 REVISED OCT., 1986