

CHEBOYGAN COUNTY REMONUMENTATION CORNER

LAND CORNER RECORDATION CERTIFICATE
Filing Requirement of Act 74, Mich. P.A. 1970

RECEIVED
FOR RECORD

99 DEC -6 PM 3: 03

For corners in

CHEBOYGAN Located In: Corner Code #
(County)

- 1. Public Land Survey T 37NR 2W G-7
T _____ R _____
T _____ R _____
T _____ R _____
- 2. Property Controlling S _____ T _____ R _____
in Section S _____ T _____ R _____
- 3. Miscellaneous S _____ T _____ R _____
Property in Sec. S _____ T _____ R _____

Dick Pyszynski
CLERK/REGISTER
CHEBOYGAN COUNTY MICHIGAN

Register of Deeds Stamp & File Number

4. Lot No. _____, Recorded Plat _____

5. Private Claims _____


I, JAMES H. GRANGER, in a field survey on JULY 9, 19 99 do hereby state that under requirements of P.A. 74, Michigan P.A. of 1970, the corner points mentioned in lines 1 and 2 above were in conformance with regulations and rules therefore as required in the current manual of survey instructions of the United States Department of the Interior, Bureau of Land Management or by a decree of a Court of Law and for that the corner points mentioned in lines 3, 4 and 5 above were in conformance with the rules of the Michigan Board of Land Surveyors or by a Decree of a Court of Law; established, re-established, monumented, recovered, found as expressed below:

NOTE: Not more than 2 corners, all in the same town and range, may be recorded on this certificate.

	A	B	C	D	E	F	G	H	I	J	K	L
1												
2	6		5		4		3		2		1	
3												
4	7		8		9		10		11		12	
5												
6	18		17		16		15		14		13	
7												
8	19		20		21		22		23		24	
9												
10	30		29		28		27		26		25	
11												
12	31		32		33		34		35		36	
13												

A. Description of original monument and accessories and/or subsequent restoration:

- 1855 GLO Resurvey Set wood post 18" Elm N62°E 9 lks
Harvey Mellen 12" Cedar N45°W 15 lks
- 1967 Survey Field Notes Corner Found
Orlando Doyle #7319 No Witnesses
- 1972 Unrecorded Survey Metal Monument
Orlando Doyle #7319 No Witnesses
- 1973 LCRC Fd 1" iron
Orlando Doyle #7319
- 1997 LCRC Set ½" iron in Monument Box
Mark Ennes #25842

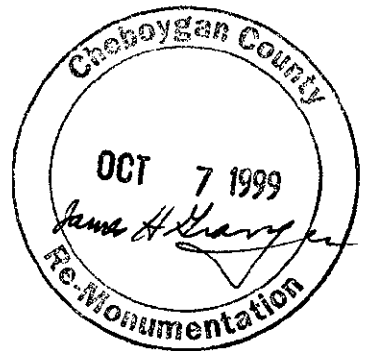


B. Description of corner evidence found and/or method applied in restoring or reestablishing corner:

Found ½" iron in Monument Box and 4 witnesses. Accepted position as established.

C. Description of monument for corner and accessories established to perpetuate location of the position of the corner:

- ½" iron in Monument Box with Remonumentation Cap
- 5" Ash S42°E 37.42' ex. nail
- N. side Maple clump N75°W 48.82' ex. nail
- 5" Balsam N64°E 41.25' ex. nail
- 5" Poplar S40°W 59.20' ex. nail

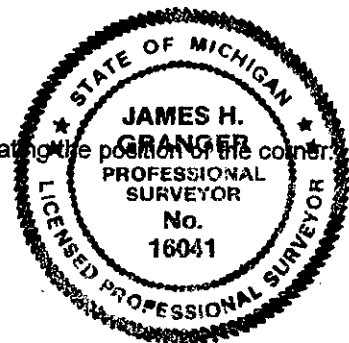

Signed by James H. Granger
Surveyor's Michigan License No. 16041

Date November 12, 1999

SURVEY A
RF

MAR 03 2000

SECTION

LIBER 011 PAGE 148