

CHEBOYGAN COUNTY REMONUMENTATION CORNER

LAND CORNER RECORDATION CERTIFICATE

Filing Requirement of Act 74, Mich. P.A. 1970

RECEIVED FOR RECORD

99 DEC -6 PM 3:13

For corners in

CHEBOYGAN Located In: Corner Code #
(County)

- 1. Public Land Survey T 37NR 2W G-9
T R
T R
T R
- 2. Property Controlling S T R
in Section S T R
- 3. Miscellaneous S T R
Property in Sec. S T R

Debra Pyszynski
CLERK/REGISTER
CHEBOYGAN COUNTY MICHIGAN

Register of Deeds Stamp & File Number

4. Lot No. _____, Recorded Plat _____

5. Private Claims _____


I, JAMES H. GRANGER, in a field survey on JULY 9, 19 99 do hereby state that under requirements of P.A. 74, Michigan P.A. of 1970, the corner points mentioned in lines 1 and 2 above were in conformance with regulations and rules therefore as required in the current manual of survey instructions of the United States Department of the Interior, Bureau of Land Management or by a decree of a Court of Law and/or that the corner points mentioned in lines 3, 4 and 5 above were in conformance with the rules of the Michigan Board of Land Surveyors or by a Decree of a Court of Law; established, re-established, monumented, recovered, found as expressed below:

NOTE: Not more than 2 corners, all in the same town and range, may be recorded on this certificate.

	A	B	C	D	E	F	G	H	I	J	K	L	I
1													
2	6		5		4		3		2		1		
3													
4	7		8		9		10		11		12		
5													
6	18		17		16		15		14		13		
7													
8	19		20		21		22		23		24		
9													
10	30		29		28		27		26		25		
11													
12	31		32		33		34		35		36		
13													

A. Description of original monument and accessories and/or subsequent restoration:

- 1855 GLO Resurvey Set wood post 10" Hemlock N82°W 8 lks
Harvey Meilen 12" Sugar S40°W 25 lks
- 1971 LCRC Fd. 1" pipe
Orlando Doyle #7319 3 witnesses set
- 1988 LCRC Fd. 1-1/4" iron
James H. Granger #16041 4 witnesses set
- 1997 LCRC set 1/2" iron in Monument Box
Mark Ennes #25842 4 witnesses set

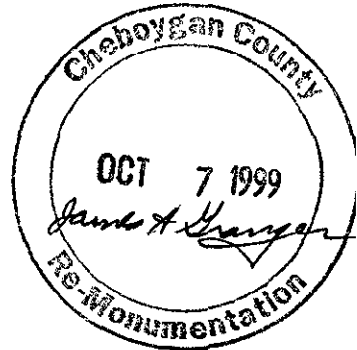

B. Description of corner evidence found and/or method applied in restoring or reestablishing corner:

Found 1/2" iron in Monument Box and 4 witnesses, 3 partially overgrown. Accepted position as established.

C. Description of monument for corner and accessories established to perpetuate locating the position of the corner:

- 1/2" iron in Monument Box with Remonumentation Cap
- 1" pipe (prop corner) N45°W 46.67'
- 6" Poplar N60°W 53.33' nail & tag #16041
- 8" Poplar S70°W 68.60' nail & tag #16041
- 6" White Pine S47°E 65.58' nail & tag #16041



Signed by James H. Granger
Surveyor's Michigan License No. 16041

Date November 12, 1999

FORM APPROVED BY MICHIGAN STATE BOARD OF PROFESSIONAL SURVEYORS, JAN. 28, 1971

REVISED 14, 1975
REVISED JAN. 1986
REVISED OCT., 1998

RECORDED

MAR 03 2000

SECTION

LIBER 011 PAGE 155