

CHEBOYGAN COUNTY REMONUMENTATION CORNER

LAND CORNER RECORDATION CERTIFICATE  
Filing Requirement of Act 74, Mich. P.A. 1970

RECEIVED  
FOR RECORD

99 DEC -6 PM 3: 03

For corners in

CHEBOYGAN Located In: Corner Code #  
(County)

- 1. Public Land Survey T 37NR 2W H-5  
T R  
T R  
T R
- 2. Property Controlling S T R  
in Section S T R
- 3. Miscellaneous S T R  
Property in Sec. S T R

*Wally Szymanski*  
CLERK/REGISTER  
CHEBOYGAN COUNTY MICHIGAN

Register of Deeds Stamp & File Number

4. Lot No. \_\_\_\_\_, Recorded Plat \_\_\_\_\_

5. Private Claims \_\_\_\_\_

I, JAMES H. GRANGER, in a field survey on JULY 9, 19 99 do hereby state that under requirements of P.A. 74, Michigan P.A. of 1970, the corner points mentioned in lines 1 and 2 above were in conformance with regulations and rules therefore as required in the current manual of survey instructions of the United States Department of the Interior, Bureau of Land Management or by a decree of a Court of Law and /or that the corner points mentioned in lines 3, 4 and 5 above were in conformance with the rules of the Michigan Board of Land Surveyors or by a Decree of a Court of Law; established, re-established, monumented, recovered, found as expressed below:

NOTE: Not more than 2 corners, all in the same town and range, may be recorded on this certificate.

	A	B	C	D	E	F	G	H	I	J	K	L	M
1													
2	6		5		4		3		2		1		
3													
4	7		8		9		10		11		12		
5													
6	18		17		16		15		14		13		
7													
8	19		20		21		22		23		24		
9													
10	30		29		28		27		26		25		
11													
12	31		32		33		34		35		36		
13													

A. Description of original monument and accessories and/or subsequent restoration:

- 1855 GLO Resurvey Set wood post 36" W. Pine N 3°E 30 lks  
Harvey Mellen 28" W. Pine South 16 lks
- 1973 LCRC Set 5/8" pipe  
Orlando Doyle #7319 3 witnesses
- 1992 LCRC Fd 5/8" pipe and 1 witness  
James H. Granger #16041 set 3 witnesses
- 1997 Recorded Survey Fd 5/8" pipe and 4 witnesses  
James H. Granger #16041




B. Description of corner evidence found and/or method applied in restoring or reestablishing corner:

Found 5/8" pipe and 2 witnesses per LCRC. Accepted position as established. Replaced 5/8" pipe with 5/8" rebar

C. Description of monument for corner and accessories established to perpetuate locating the position of the corner:

- 5/8" rebar with Remonumentation Cap
- Power Pole North 28.36' Fd nail & tag #16041
- 6" Spruce S20°W 72.30' Fd nail & tag #16041
- 4" Spruce S29°E 42.69' Nail & tag #16041
- 6" Spruce N64°W 44.80' Nail & tag #16041

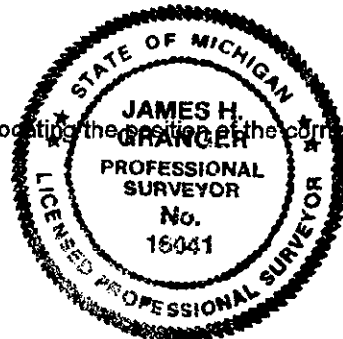

Signed by James H. Granger  
Surveyor's Michigan License No. 16041

Date November 12, 1999