

CHEBOYGAN COUNTY REMONUMENTATION CORNER

LAND CORNER RECORDATION CERTIFICATE  
Filing Requirement of Act 74, Mich. P.A. 1970

RECEIVED  
FOR RECORD

99 DEC -6 PM 3: 07

*Chick Pyzyrski*

CLERK/REGISTER  
CHEBOYGAN COUNTY MICHIGAN

For corners in

<u>CHEBOYGAN</u> (County)	Located in:	Corner Code #
1. Public Land Survey	T 37NR 2W	1-2
	T ___ R ___	_____
	T ___ R ___	_____
	T ___ R ___	_____
2. Property Controlling in Section	S ___ T ___ R ___	_____
	S ___ T ___ R ___	_____
3. Miscellaneous Property in Sec.	S ___ T ___ R ___	_____
	S ___ T ___ R ___	_____

Register of Deeds Stamp & File Number

4. Lot No. \_\_\_\_\_, Recorded Plat \_\_\_\_\_  
5. Private Claims \_\_\_\_\_


I, JAMES H. GRANGER, in a field survey on JULY 9, 19 99 do hereby state that under requirements of P.A. 74, Michigan P.A. of 1970, the corner points mentioned in lines 1 and 2 above were in conformance with regulations and rules therefore as required in the current manual of survey instructions of the United States Department of the Interior, Bureau of Land Management or by a decree of a Court of Law and /or that the corner points mentioned in lines 3, 4 and 5 above were in conformance with the rules of the Michigan Board of Land Surveyors or by a Decree of a Court of Law; established, re-established, monumented, recovered, found as expressed below:

NOTE: Not more than 2 corners, all in the same town and range, may be recorded on this certificate.

A	B	C	D	E	F	G	H	I	J	K	L	M
1												
2	6	5	4	3	2	1						
3												
4	7	8	9	10	11	12						
5												
6	18	17	16	15	14	13						
7												
8	19	20	21	22	23	24						
9												
10	30	29	28	27	26	25						
11												
12	31	32	33	34	35	36						
13												

A. Description of original monument and accessories and/or subsequent restoration:

1955 GLO Resurvey Harvey Mellen	Set wood post	6" Tamarack 6" Fir	N20°W S10°W	49 lks 12 lks
1972 Survey by Orlando Doyle #7319	Fd 3/4" pipe Set 3 witnesses			
1988 Survey & LCRC James H. Granger #16041	Fd 1/2" iron in Monument Box Set 4 witnesses			

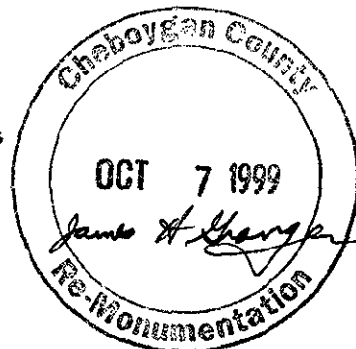

B. Description of corner evidence found and/or method applied in restoring or reestablishing corner:

Found 1/2" rod in Monument Box and 4 witnesses. Accepted position as established and replaced 1/2" iron with 5/8" rebar.

C. Description of monument for corner and accessories established to perpetuate location of the corner:

5/8" rebar in Monument Box with Remonumentation Cap			
Power Pole	S58°E	40.65'	Nail & cap #16041
3" Birch	S37°W	65.43'	Nail & cap #16041
4" Poplar	N52°W	65.37'	Nail & cap #16041
Stop Sign	S78°W	67.00'	Nail & cap #16041



Signed by James H. Granger  
Surveyor's Michigan License No. 16041

Date November 12, 1999

SURVEY &  
RE...

MAR 03 2000

SECTION

FORM APPROVED BY MICHIGAN STATE BOARD OF PROFESSIONAL SURVEYORS, JAN. 28, 1971

REVISED 14, 1975  
REVISED JAN., 1983  
REVISED OCT., 1995