

CHEBOYGAN COUNTY REMONUMENTATION CORNER

LAND CORNER RECORDATION CERTIFICATE
Filing Requirement of Act 74, Mich. P.A. 1970

For corners in

CHEBOYGAN Located In: Corner Code #
(County)

1. Public Land Survey T 37NR 2W I-3
T R
T R
T R

2. Property Controlling S T R
in Section S T R

3. Miscellaneous S T R
Property in Sec. S T R

RECEIVED FOR RECORD 1218-97
at 11:37 O'Clock A M

Joanne Spray

CLERK/REGISTER
CHEBOYGAN COUNTY, MICHIGAN
Register of Deeds Stamp & File Number

4. Lot No. _____, Recorded Plat _____
5. Private Claims _____


	A	B	C	D	E	F	G	H	I	J	K	L	M
1													
2	6		5		4		3		2		1		
3													
4	7		8		9		10		11		12		
5													
6	18		17		16		15		14		13		
7													
8	19		20		21		22		23		24		
9													
10	30		29		28		27		26		25		
11													
12	31		32		33		34		35		36		
13													

I, JAMES H. GRANGER, in a field survey on JULY 15, 1997 do hereby state that under requirements of P.A. 74, Michigan P.A. of 1970, the corner points mentioned in lines 1 and 2 above were in conformance with regulations and rules therefore as required in the current manual of survey instructions of the United States Department of the Interior, Bureau of Land Management or by a decree of a Court of Law and /or that the corner points mentioned in lines 3, 4 and 5 above were in conformance with the rules of the Michigan Board of Land Surveyors or by a Decree of a Court of Law, established, re-established, monumented, recovered, found as expressed below:

NOTE: Not more than 2 corners, all in the same town and range, may be recorded on this certificate.

- A. Description of original monument and accessories and/or subsequent restoration:
- I-3 1855 Original Survey Set wood post 10" Elm S29°E 33 lks
Harvey Mellen 18" W. Pine N58°W 24 lks
 - 1953 LCRC 1/2" pipe
Orlando Doyle #7319
 - 1978 LCRC Metal Monument
Orlando Doyle #7319
 - 1996 Survey 1/2" pipe in Monument Box
James H. Granger #16041
 - 1996 LCRC 1/2" pipe in Monument Box
James H. Granger #16041
 - 1997 Survey 1/2" pipe in Monument Box
James H. Granger #16041

SURVEY &
REMONUMENTATION
FEB 26 1998
SECTION

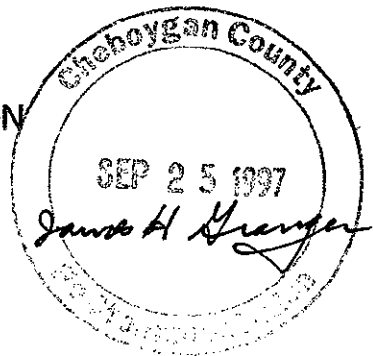


- B. Description of corner evidence found and/or method applied in restoring or reestablishing corner:
- I-3 Found 1/2" pipe in Monument Box and 3 witnesses from 1996 LCRC. Replaced with 5/8" rebar and remonumentation cap.

- C. Description of monument for corner and accessories established to perpetuate locating the position of the corner:
- 3 5/8" rebar and Remonumentation Cap in Monument Box
5" Pine N43°E 98.16' Fd tag #16041
4" Poplar N20°W 83.42' Fd tag #16041
Stop sign S81°W 57.90' Fd tag #16041
14" Poplar S42°E 90.41' Set tag #16041

Signed by James H. Granger
License No. 16041

Date Nov 17, 1997 Surveyor's Michigan

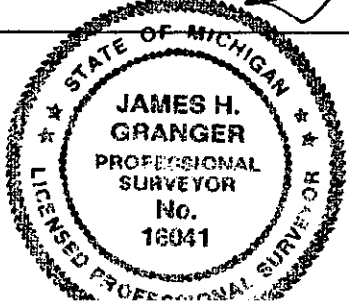

FORM APPROVED BY MICHIGAN STATE BOARD OF PROFESSIONAL SURVEYORS, JAN. 28, 1971
REVISED 14, 1976

REVISED JAN., 1983
REVISED OCT., 1996