

CHEBOYGAN COUNTY REMONUMENTATION CORNER

LAND CORNER RECORDATION CERTIFICATE
Filing Requirement of Act 74, Mich. P.A. 1970

RECEIVED
FOR RECORD

99 DEC -6 PM 3:08

For corners in

CHEBOYGAN Located In: Corner Code #
(County)

- 1. Public Land Survey T 37NR 2W 1-4
T R
T R
T R
- 2. Property Controlling S T R
in Section S T R
- 3. Miscellaneous S T R
Property in Sec. S T R

Sally Popynski
CLERK/REGISTER
CHEBOYGAN COUNTY MICHIGAN

Register of Deeds Stamp & File Number

4. Lot No. _____, Recorded Plat _____

5. Private Claims _____

I, JAMES H. GRANGER, in a field survey on JULY 12, 19 99 do hereby state that under requirements of P.A. 74, Michigan P.A. of 1970, the corner points mentioned in lines 1 and 2 above were in conformance with regulations and rules therefore as required in the current manual of survey instructions of the United States Department of the Interior, Bureau of Land Management or by a decree of a Court of Law and for that the corner points mentioned in lines 3, 4 and 5 above were in conformance with the rules of the Michigan Board of Land Surveyors or by a Decree of a Court of Law; established, re-established, monumented, recovered, found as expressed below:

NOTE: Not more than 2 corners, all in the same town and range, may be recorded on this certificate.

| | A | B | C | D | E | F | G | H | I | J | K | L | M |
|----|----|---|----|---|----|---|----|---|----|---|----|---|---|
| 1 | | | | | | | | | | | | | |
| 2 | 6 | | 5 | | 4 | | 3 | | 2 | | 1 | | |
| 3 | | | | | | | | | | | | | |
| 4 | 7 | | 8 | | 9 | | 10 | | 11 | | 12 | | |
| 5 | | | | | | | | | | | | | |
| 6 | 18 | | 17 | | 16 | | 15 | | 14 | | 13 | | |
| 7 | | | | | | | | | | | | | |
| 8 | 19 | | 20 | | 21 | | 22 | | 23 | | 24 | | |
| 9 | | | | | | | | | | | | | |
| 10 | 30 | | 29 | | 28 | | 27 | | 26 | | 25 | | |
| 11 | | | | | | | | | | | | | |
| 12 | 31 | | 32 | | 33 | | 34 | | 35 | | 36 | | |
| 13 | | | | | | | | | | | | | |

A. Description of original monument and accessories and/or subsequent restoration:

- 1855 GLO Resurvey Set wood post 24" W. Pine S70°W 30 lks
Harvey Mellen 20" W. Pine S71°E 23 lks
- 1953 LCRC Fd. 3/4" pipe
Orlando Doyle #7319 No witnesses
- 1978 Recorded Survey Indicate metal monument
Orlando Doyle #7319
- 1998 Recorded Survey Fd. 3/4" pipe
James H. Granger #16041




B. Description of corner evidence found and/or method applied in restoring or reestablishing corner:

Found 3/4" pipe. Accepted position as established. Replaced 3/4" pipe with 5/8" rebar.

C. Description of monument for corner and accessories established to perpetuate location the position of the corner:

- 5/8" rebar with Remonumentation Cap
- 4" Red Pine S53°E 56.95' Nail & tag #16041
- Power Pole S80°E 37.50' Nail & tag #16041
- 14" Red Pine S28°W 78.58' Nail & tag #16041
- 14" Red Pine N35°W 59.18' Nail & tag #16041

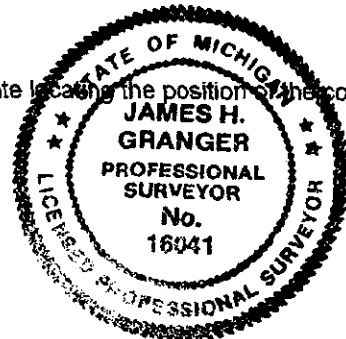

Signed by James H. Granger
Surveyor's Michigan License No. 16041

Date November 12, 1999

MAR 03 2000

LIBER 011 PAGE 151

SECTION