CHEBOYGAN COUNTY REMONUMENTATION CORNER

LAND CORNER RECORDATION CERTIFICATE
Filing Requirement of Act 74, Mich. P.A. 1970

RECEIVED FOR RECORD 12-18-97
at 11:38 O'Clock A M

Joanne Spray

CLERK/REGISTER
CHEBOYGAN COUNTY, MICHIGAN

Register of Deeds Stamp & File Number

For corners in

CHEBOYGAN
(County)

	Located In:	Corner Code #
1. Public Land Survey	T 37N R 2W	I-5
	T___ R___	
	T___ R___	
	T___ R___	
2. Property Controlling in Section	S___ T___ R___	
	S___ T___ R___	
3. Miscellaneous Property in Sec.	S___ T___ R___	
	S___ T___ R___	

4. Lot No. _____, Recorded Plat _____
5. Private Claims _____

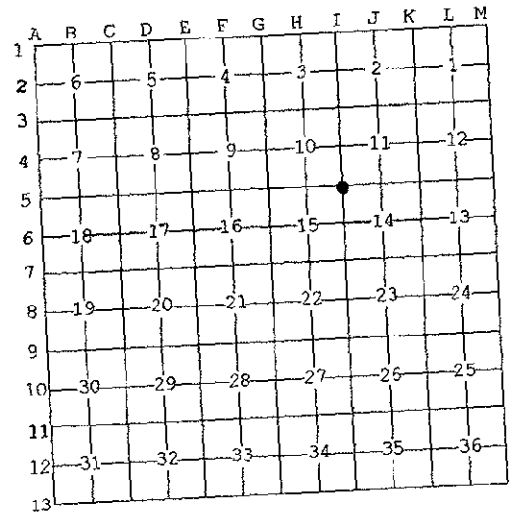

I, JAMES H. GRANGER, in a field survey on JULY 15, 19 97 do hereby state that under requirements of P.A. 74, Michigan P.A. of 1970, the corner points mentioned in lines 1 and 2 above were in conformance with regulations and rules therefore as required in the current manual of survey instructions of the United States Department of the Interior, Bureau of Land Management or by a decree of a Court of Law and /or that the corner points mentioned in lines 3, 4 and 5 above were in conformance with the rules of the Michigan Board of Land Surveyors or by a Decree of a Court of Law: established, re-established, remonumented, recovered, found as expressed below:

NOTE: Not more than 2 corners, all in the same town and range, may be recorded on this certificate.

A. Description of original monument and accessories and/or subsequent restoration:

I-5 1855 Original Survey Harvey Mellen	Set wood post	14" Hemlock	S37°W	22 lks
		10" Sugar	N72°E	20 lks
1953 LCRC Orlando Doyle #7319	1/2" rod with wood stake			
1968 Survey Kenneth Larsen #10695	Corner shown			
1971 Survey Orlando Doyle #7319	Corner shown			
1973 LCRC Orlando Doyle #7319	1/2" rod			
1981 LCRC Mark Ennes #25842	1/2" rod with cap #25842			
1993 Survey James H. Granger #16041	1/2" rod with cap #25842			

Cheboygan County
SEP 25 1997
James H. Granger

SURVEY & REMONUMENTATION

FEB 26 1998

SECTION

B. Description of corner evidence found and/or method applied in restoring or reestablishing corner:

I-5 Found 1/2" rod with cap #25842 in monument Box and 3 witnesses from 1981 LCRC. Set remonumentation Cap on 1/2" iron in Monument Box.

C. Description of monument for corner and accessories established to perpetuate locating the position of the corner:

I-5 ½" iron and remonumentation cap in Monument Box

Fence corner	N57°E	40.88'	Fd tag #22428
6" Pine	N26°E	78.21'	Fd tag #22428
Fence post	S42°E	41.60'	Fd nail and washer
Fence post	S54°W	42.02'	Set tag #16041

Signed by James H Granger Date Nov 17, 1997 Surveyor's Michigan License No. 16041

STATE OF MICHIGAN
JAMES H. GRANGER
PROFESSIONAL SURVEYOR
No. 16041
LICENSED SURVEYOR

FORM APPROVED BY MICHIGAN STATE BOARD OF PROFESSIONAL SURVEYORS, JAN. 28, 1971
REVISED 14,1976
REVISED JAN., 1983
REVISED OCT., 1996

LIBER 011 PAGE 42