**CHEBOYGAN COUNTY REMONUMENTATION CORNER**

**LAND CORNER RECORDATION CERTIFICATE**
**Filing Requirement of Act 74, Mich. P.A. 1970**

RECEIVED
FOR RECORD
99 DEC -6 PM 3:09
Vicky Pyzynski
CLERK/REGISTER
CHEBOYGAN COUNTY MICHIGAN

**Register of Deeds Stamp & File Number**

For corners in

CHEBOYGAN (County) Located in: Corner Code #

| | | | |
|---|---|---|---|
| 1. Public Land Survey | | T 37NR 2W | I-7 |
| | | T___ R___ | |
| | | T___ R___ | |
| | | T___ R___ | |
| 2. Property Controlling | S___ | T___ R___ | |
| in Section | S___ | T___ R___ | |
| 3. Miscellaneous | S___ | T___ R___ | |
| Property in Sec. | S___ | T___ R___ | |

4. Lot No. _____ , Recorded Plat _____

5. Private Claims _____

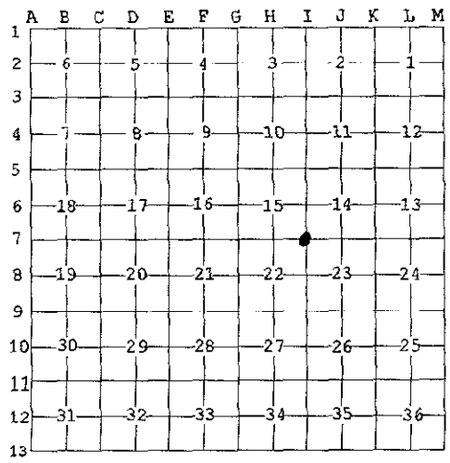


I, JAMES H. GRANGER, in a field survey on JULY 9, 19 99 do hereby state that under requirements of P.A. 74, Michigan P.A. of 1970, the corner points mentioned in lines 1 and 2 above were in conformance with regulations and rules therefore as required in the current manual of survey instructions of the United States Department of the Interior, Bureau of Land Management or by a decree of a Court of Law and /or that the corner points mentioned in lines 3, 4 and 5 above were in conformance with the rules of the Michigan Board of Land Surveyors or by a Decree of a Court of Law; established, re-established, monumented, recovered, found as expressed below:

**NOTE: Not more than 2 corners, all in the same town and range, may be recorded on this certificate.**

A. Description of original monument and accessories and/or subsequent restoration:

| | | | | |
|---|---|---|---|---|
| 1855 GLO Resurvey<br>Harvey Mellen | Set wood post | 20" Sugar<br>10" Sugar | N87°W<br>S16°E | 51 lks<br>11 lks |
| 1972 Survey<br>Kenneth Larsen #10685 | Indicates corner<br>no witnesses | | | |
| 1973 LCRC<br>Orlando Doyle #7319 | Fd. 1" axle<br>3 witnesses | | | |
| 1976 Plat of Laperell Acres<br>Orlando Doyle #7319 | Indicates concrete monument.<br>no witnesses | | | |

Cheboygan County
OCT 7 1999
James H Granger
Re-Monumentation

B. Description of corner evidence found and/or method applied in restoring or reestablishing corner:

Found 1" axle in Monument Box and 3 witnesses. Accepted position as established. Replaced 1" axle with 5/8" rebar. Found existing witness tags for Ron Bischer #22428. No LCRC recorded.

C. Description of monument for corner and accessories established to perpetuate locating the position of the corner:

5/8" rebar with Remonumentation Cap

| | | | |
|---|---|---|---|
| 48" Maple | S69°W | 35.91' | Fd nail & tag #22428 |
| Power Pole | N11°W | 98.42' | Fd nail & tag #22428 |
| SE house corner | N40°W | 147.04' | Fd nail & tag #22428 |
| 4" Cherry | S55°E | 94.96' | Fd nail & tag #22428 |

STATE OF MICHIGAN
JAMES H. GRANGER
PROFESSIONAL SURVEYOR
No. 16041
LICENSED PROFESSIONAL SURVEYOR

Signed by James H Granger Date November 12, 1999

Surveyor's Michigan License No. 16041

FORM APPROVED BY MICHIGAN STATE BOARD OF PROFESSIONAL SURVEYORS, JAN. 28, 1971
REVISED 14,1975
REVISED JAN., 1983
REVISED OCT., 1995

MAR 0 3 2000

SECTION

LIBER 011 PAGE 152