

CHEBOYGAN COUNTY REMONUMENTATION CORNER

LAND CORNER RECORDATION CERTIFICATE
Filing Requirement of Act 74, Mich. P.A. 1970

For corners in

CHEBOYGAN
(County)

Located In:

Corner Code #

1. Public Land Survey

T 37NR 2W
J-3
T R
T R
T R
S T R
S T R
S T R
S T R

2. Property Controlling in Section

3. Miscellaneous Property in Sec.

4. Lot No. _____, Recorded Plat _____
5. Private Claims _____

RECEIVED FOR RECORD 12-18-97
at 11:40 O'Clock A.M.

Joanne Spray

CLERK/REGISTER
CHEBOYGAN COUNTY, MICHIGAN

Register of Deeds Stamp & File Number

I, JAMES H. GRANGER, in a field survey on JULY 15, 19 97 do hereby state that under requirements of P.A. 74, Michigan P.A. of 1970, the corner points mentioned in lines 1 and 2 above were in conformance with regulations and rules therefore as required in the current manual of survey instructions of the United States Department of the Interior, Bureau of Land Management or by a decree of a Court of Law and for that the corner points mentioned in lines 3, 4 and 5 above were in conformance with the rules of the Michigan Board of Land Surveyors or by a Decree of a Court of Law; established, re-established, monumented, recovered, found as expressed below:

NOTE: Not more than 2 corners, all in the same town and range, may be recorded on this certificate.

A. Description of original monument and accessories and/or subsequent restoration:

J-3 1840 Original Survey Set wood post 8" Maple S61°E 15 lks
John Mullett 12" Aspen S76°W 20 lks

1953 Survey Corner shown
Orlando Doyle #7319

1953 LCRC 3/4" pipe
Orlando Doyle #7319

1996 Survey Raised pipe with 1/2" iron
James H. Granger #16041


1996 LCRC 1/2" iron
James H. Granger #16041

1	A	B	C	D	E	F	G	H	I	J	K	L	M
2	6		5		4		3		2		1		
3													
4	7		8		9		10		11		12		
5													
6	18		17		16		15		14		13		
7													
8	19		20		21		22		23		24		
9													
10	30		29		28		27		26		25		
11													
12	31		32		33		34		35		36		
13													

SURVEY & REMONUMENTATION

FEB 26 1998

SECTION

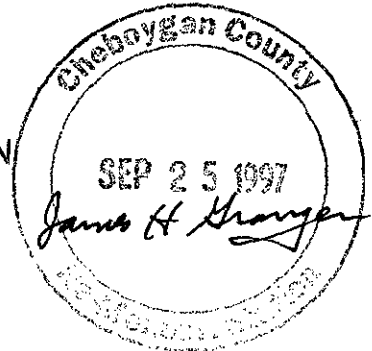

B. Description of corner evidence found and/or method applied in restoring or reestablishing corner:

J-3 Found 1/2" iron and 4 witnesses from 1996 LCRC. Replaced with 5/8" rebar and remonumentation cap in Monument Box.

C. Description of monument for corner and accessories established to perpetuate locating the position of the corner:


J-3 5/8" rebar and Remonumentation Cap in Monument Box

PP	S 2°E	26.99'	Fd tag #16041
4" Spruce	N44°W	56.65'	Fd tag #16041
Twin 6" Ash	N20°W	34.52'	Fd tag #16041
PP	N84°E	76.70'	Fd tag #16041

Signed by James H. Granger

Date Nov 17, 1997 Surveyor's Michigan

License No. 16041

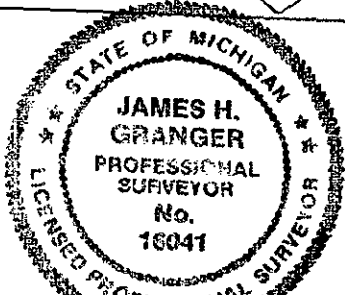

FORM APPROVED BY MICHIGAN STATE BOARD OF PROFESSIONAL SURVEYORS, JAN. 28, 1971
REVISED 14, 1976

REVISED JAN., 1983
REVISED OCT., 1996