

CHEBOYGAN COUNTY REMONUMENTATION CORNER

LAND CORNER RECORDATION CERTIFICATE
Filing Requirement of Act 74, Mich. P.A. 1970

RECEIVED
FOR RECORD

99 DEC -6 PM 3:10

For corners in

CHEBOYGAN Located In: Corner Code #
(County)

- 1. Public Land Survey T 37NR 2W J-5
T R
T R
T R
- 2. Property Controlling in Section S T R
S T R
- 3. Miscellaneous Property in Sec. S T R
S T R

W. J. Pyzycki
CLERK/REGISTER
CHEBOYGAN COUNTY MICHIGAN

Register of Deeds Stamp & File Number

4. Lot No. _____, Recorded Plat _____

5. Private Claims _____


	A	B	C	D	E	F	G	H	I	J	K	L	I
1													
2	6		5		4		3		2			1	
3													
4	7		8		9		10		11		12		
5													
6	18		17		16		15		14		13		
7													
8	19		20		21		22		23		24		
9													
10	30		29		28		27		26		25		
11													
12	31		32		33		34		35		36		
13													

I, JAMES H. GRANGER, in a field survey on JULY 9, 1999 do hereby state that under requirements of P.A. 74, Michigan P.A. of 1970, the corner points mentioned in lines 1 and 2 above were in conformance with regulations and rules therefore as required in the current manual of survey instructions of the United States Department of the Interior, Bureau of Land Management or by a decree of a Court of Law and /or that the corner points mentioned in lines 3, 4 and 5 above were in conformance with the rules of the Michigan Board of Land Surveyors or by a Decree of a Court of Law; established, re-established, monumented, recovered, found as expressed below:

NOTE: Not more than 2 corners, all in the same town and range, may be recorded on this certificate.

A. Description of original monument and accessories and/or subsequent restoration:

1855 GLO Resurvey Harvey Mellen	Set wood post	14" Cedar Stump 12" Cedar	N10°E 25 lks S 9°W 3 lks
1953 LCRC Orlando Doyle #7319	Set 3/4" pipe 3 witnesses		

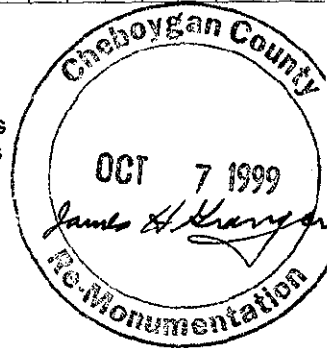

B. Description of corner evidence found and/or method applied in restoring or reestablishing corner:

Found 3/4" pipe and rotted Cedar stump per Doyle LCRC. Accepted position as established. Replaced pipe with 5/8" rebar. Found ex. witness tags of Ron Bischer #22428. No LCRC recorded.

C. Description of monument for corner and accessories established to perpetuate location of the corner:

5/8" rebar with Remonumentation Cap
4" Apple N64°W 69.24' Fd nail & tag #22428
MBT Box N20°W 24.80' Nail & tag #16041
4" Birch N46°E 24.20' Fd nail & tag #22428
5" Poplar N79°E 56.33' Nail & tag #16041



Signed by James H. Granger
Surveyor's Michigan License No. 16041

Date November 12, 1999

SURVEY &
RE...

MAR 03 2000

SECTION