

JAN 23 1996

CHEBOYGAN COUNTY REMONUMENTATION
LAND CORNER RECORDATION CERTIFICATE
Filing Requirement of Act 74, Mich. P.A. 1970

For corners in **COMMISSION**

Cheboygan (County)	Located In:	Corner Code ##
1. Public Land Survey	T <u>37N</u> R <u>2W</u>	<u>K-2</u>
	T _____ R _____	_____
	T _____ R _____	_____
	T _____ R _____	_____
2. Property Controlling in Section	S _____ T _____ R _____	_____
	S _____ T _____ R _____	_____
3. Miscellaneous Property in Sec.	S _____ T _____ R _____	_____
	S _____ T _____ R _____	_____

RECEIVED
FOR RECORD
95 DEC 11 PM 4:50
James H. Granger
CLERK/REGISTER
CHEBOYGAN COUNTY, MICHIGAN
Register of Deeds Stamp & File Number

4. Lot No. _____, Recorded Plat _____
5. Private Claims _____

	A	B	C	D	E	F	G	H	I	J	K	L	M
2	6	5	4	3	2	1							
3													
4	7	8	9	10	11	12							
5													
6	18	17	16	15	14	13							
7													
8	19	20	21	22	23	24							
9													
10	30	29	28	27	26	25							
11													
12	31	32	33	34	35	36							
13													

I, James H. Granger, in a field survey on August 4, 19 95, do hereby certify that under requirements of P.A. 74, Michigan P.A. of 1970, the corner points mentioned in lines 1 and 2 above were in conformance with regulations and rules therefore as required in the current manual of survey instructions of the United States/Department of the Interior, Bureau of Land Management or by a decree of a Court of Law and/or that the corner points mentioned in lines 3, 4 and 5 above were in conformance with the rules of the Michigan Board of Land Surveyors or by a Decree of a Court of Law; established, re-established, monumented, re-monumented, recovered, found as expressed below:

NOTE: Not more than 4 corners, all in the same town and range, may be recorded on this certificate.

A. Description of original monument and accessories and/or subsequent restoration:


- 1840 Original Survey Set wood post 10" White Pine N65°E 381ks 8" Tammarack N62°W 91ks John Mullett
- 1964 Survey Kenneth Larson # 16095
- 1978 LCRC John Nelson #21273 1/2"rod
- 1993 LCRC Mark Ennes #25842 1/2"rod

B. Description of corner evidence found and/or method applied in restoring or reestablishing corner:

Found 5/8" rod in monument box. Placed remonumentation cap

LIBER 010 PAGE 130

Morris A. Ross

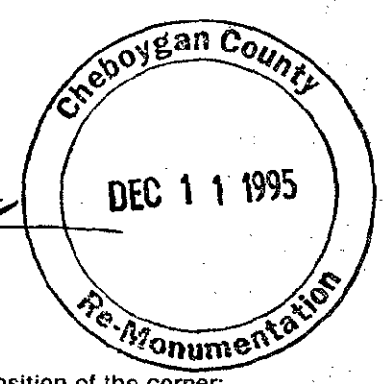

C. Description of monument for corner and accessories established to perpetuate locating the position of the corner:

5/8"rebar and remonumentation cap in monument box.

Corner Fence post	S81°E 41.95	Fd pk nails
Power Pole	N47°W 56.44	Fd pk nails
9" White Pine	N60°W 77.08	Fd pk nails
Corner Fence post	S61°W 64.27	Fd pk nails



Signed by James H. Granger

Date 10/23/95

Surveyor's Michigan License No. 16041