

**SURVEY & MONUMENTATION**

**CHEBOYGAN COUNTY REMONUMENTATION LAND CORNER RECORDATION CERTIFICATE**

**JAN 23 1996**

**Filing Requirement of Act 74, Mich. P.A. 1970**

For corners in

Cheboygan  
(County)

**COMMISSION** Filed In:

Corner Code #

1. Public Land Survey	T	<u>37N</u>	R	<u>2W</u>	<u>K-3</u>
	T	_____	R	_____	_____
	T	_____	R	_____	_____
	T	_____	R	_____	_____
2. Property Controlling in Section	S	_____	T	_____	_____
	S	_____	T	_____	_____
3. Miscellaneous Property in Sec.	S	_____	T	_____	_____
	S	_____	T	_____	_____

RECEIVED FOR RECORD  
95 DEC 11 PM 4:48

*James H. Granger*  
CLERK/REGISTER  
CHEBOYGAN COUNTY, MICHIGAN

Register of Deeds Stamp & File Number

4. Lot No. \_\_\_\_\_, Recorded Plat \_\_\_\_\_  
5. Private Claims \_\_\_\_\_

I, James H. Granger, in a field survey on August 4, 1995, do hereby certify that under requirements of P.A. 74, Michigan P.A. of 1970, the corner points mentioned in lines 1 and 2 above were in conformance with regulations and rules therefore as required in the current manual of survey instructions of the United States Department of the Interior, Bureau of Land Management or by a decree of a Court of Law and/or that the corner points mentioned in lines 3, 4 and 5 above were in conformance with the rules of the Michigan Board of Land Surveyors or by a Decree of a Court of Law; established, re-established, monumented, re-monumented, recovered, found as expressed below:

	A	B	C	D	E	F	G	H	I	J	K	L	M
2	6		5		4		3		2		1		
3													
4	7		8		9		10		11		12		
5													
6	18		17		16		15		14		13		
7													
8	19		20		21		22		23		24		
9													
10	30		29		28		27		26		25		
11													
12	31		32		33		34		35		36		
13													

**NOTE: Not more than 4 corners, all in the same town and range, may be recorded on this certificate.**

A. Description of original monument and accessories and/or subsequent restoration:


- 1840 Original Survey Set wood post 10" Tamarack N75°E 37 lks 10" Tamarack S19°E 45 lks
- 1953 LCRC Orlando Doyle # 7319 1"rod
- 1976 Survey Kenneth Larson # 21273
- 1979 Survey Orlando Doyle # 7319
- 1993 LCRC Mark Ennes # 25842 1"rod

B. Description of corner evidence found and/or method applied in restoring or reestablishing corner:

Fd 5/8" rod in monument box, set remonumentation cap.

LIBER **010** PAGE **129**


*Morris A. Russ*

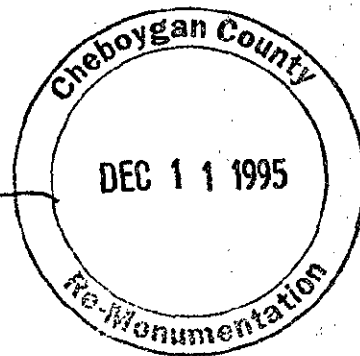

C. Description of monument for corner and accessories established to perpetuate locating the position of the corner:

5/8" rebar and remonumentation cap. in monument box.

Fence post forth from the end	S73°W 83.90	Fd pk nails w/tag
Fence corner post	S54°W 52.39	Fd pk nails w/tag
18" Maple	N10°W 126.10	Set nail w/tag
Power Pole CN19A	N75°E 157.62	Set nail w/tag

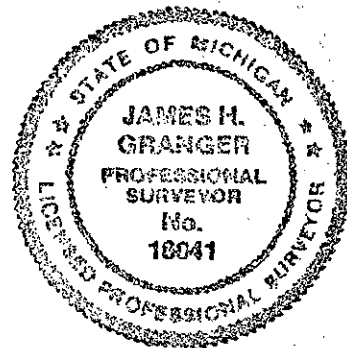

signed by James H. Granger

Date 10/23/95

Surveyor's Michigan License No. 16041