

SURVEY & MONUMENTATION

JAN 23 1996

CHEBOYGAN COUNTY REMONUMENTATION LAND CORNER RECORDATION CERTIFICATE

Filing Requirement of Act 74, Mich. P.A. 1970

COMMISSION

For corners in Cheboygan

(County)

Located In:

Corner Code #

1. Public Land Survey	T	37N	R	2W	K-4
	T		R		
	T		R		
	T		R		
2. Property Controlling in Section	S		T	R	
	S		T	R	
3. Miscellaneous Property in Sec.	S		T	R	
	S		T	R	

RECEIVED FOR RECORD

95 DEC 11 PM 4:47

James H. Granger

CLERK/REGISTER CHEBOYGAN COUNTY, MICHIGAN

Register of Deeds Stamp & File Number

- 4. Lot No. _____, Recorded Plat _____
- 5. Private Claims _____

	A	B	C	D	E	F	G	H	I	J	K	L	M
2	6		5		4		3		2				
3													
4	7		8		9		10		11		12		
5													
6	18		17		16		15		14		13		
7													
8	19		20		21		22		23		24		
9													
10	30		29		28		27		26		25		
11													
12	31		32		33		34		35		36		
13													

I, James H. Granger, in a field survey on August 4, 1995, do hereby certify that under requirements of P.A. 74, Michigan P.A. of 1970, the corner points mentioned in lines 1 and 2 above were in conformance with regulations and rules therefore as required in the current manual of survey instructions of the United States Department of the Interior, Bureau of Land Management or by a decree of a Court of Law and/or that the corner points mentioned in lines 3, 4 and 5 above were in conformance with the rules of the Michigan Board of Land Surveyors or by a Decree of a Court of Law; established, re-established, monumented, re-monumented, recovered, found as expressed below:

NOTE: Not more than 4 corners, all in the same town and range, may be recorded on this certificate.

A. Description of original monument and accessories and/or subsequent restoration:

1840 Original Survey Set wood post 14" Hemlock S6°W 40 lks 10" Maple S48°E 8 lks John Mullett


- 1951 Survey Joseph Doyle 1 1/4" axle
- 1957 LCRC Orlando Doyle # 7319 bolt in pipe
- 1975 Survey Orlando Doyle # 7319
- 1981 Survey Orlando Doyle # 7319
- 1992 LCRC Mark Ennes # 25842 1" pipe

B. Description of corner evidence found and/or method applied in restoring or reestablishing corner:

Found 3/4" rod. Replaced with 5/8" rebar and remonumentation cap in monument box.

LIBER **010** PAGE **128**


Marvin A. Ross

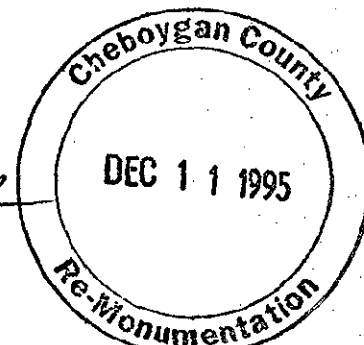

Description of monument for corner and accessories established to perpetuate locating the position of the corner:

5/8" rebar and remonumentation cap in monument box.

Power Pole K197	N88°W	39.47	Fd pk nail
10" Pine	N22°W	94.13	Fd pk nail
Power Pole CN12B	S14°E	149.39	Set nail w/tag
Power Pole	S70°E	201.24	Set nail w/tag

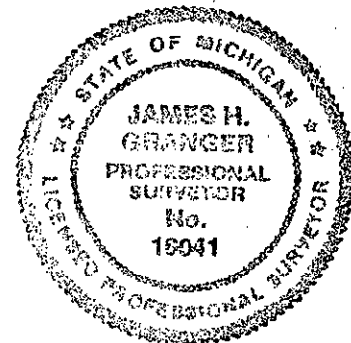

Signed by James H. Granger

Date 10/23/95

Surveyor's Michigan License No. 16041