

SURVEY & MONUMENTATION

JAN 23 1996 CHEBOYGAN COUNTY REMONUMENTATION LAND CORNER RECORDATION CERTIFICATE COMMISSION Filing Requirement of Act 74, Mich. P.A. 1970

For corners in Cheboygan (County)

Located In: Corner Code #

1. Public Land Survey	T	37N	R	2W	K-5
	T		R		
	T		R		
	T		R		
2. Property Controlling in Section	S		T	R	
	S		T	R	
3. Miscellaneous Property in Sec.	S		T	R	
	S		T	R	

RECEIVED FOR RECORD

95 DEC 11 PM 4:43

James H. Granger
CLERK/REGISTER
CHEBOYGAN COUNTY, MICHIGAN

Register of Deeds Stamp & File Number

- 4. Lot No. _____, Recorded Plat _____
- 5. Private Claims _____

A	B	C	D	E	F	G	H	I	J	K	L	M
2	6	5	4	3	2	1						
3												
4	7	8	9	10	11	12						
5												
6	16	17	16	15	14	13						
7												
8	19	20	21	22	23	24						
9												
10	30	29	28	27	26	25						
11												
12	31	32	33	34	35	36						
13												

I, James H. Granger, in a field survey on August 4, 19 95, do hereby certify that under requirements of P.A. 74, Michigan P.A. of 1970, the corner points mentioned in lines 1 and 2 above were in conformance with regulations and rules therefore as required in the current manual of survey instructions of the United States Department of the Interior, Bureau of Land Management or by a decree of a Court of Law and/or that the corner points mentioned in lines 3, 4 and 5 above were in conformance with the rules of the Michigan Board of Land Surveyors or by a Decree of a Court of Law; established, re-established, monumented, re-monumented, recovered, found as expressed below:

NOTE: Not more than 4 corners, all in the same town and range, may be recorded on this certificate.

A. Description of original monument and accessories and/or subsequent restoration:


- 1840 Original Survey Set wood post 10" Black Ash S8°W 31ks 10" Cedar N48°E 4 1ks John Mullett
- 1900 C. Surveyor
- 1967 LCRC Orlando Doyle # 7319 conc. mon.(orig. witnesses gone)
- 1988 LCRC James H. Granger # 16041 3/4"rod

B. Description of corner evidence found and/or method applied in restoring or reestablishing corner:

Found 3/4" rod. Replaced with 5/8" rebar and remonumentation cap.

LIBER 010 PAGE 127


Marvin A. Ross

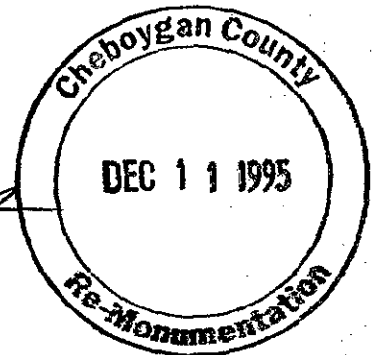

Description of monument for corner and accessories established to perpetuate locating the position of the corner:

5/8" rebar and remonumentation cap in monumnet box.

Power Pole	S63°W	44.67	Fd tag
Fence post	N48°W	51.85	Fd tag
Gas line marker Post	N69°E	66.80	Fd tag
Fence post	S30°E	52.98	Fd tag

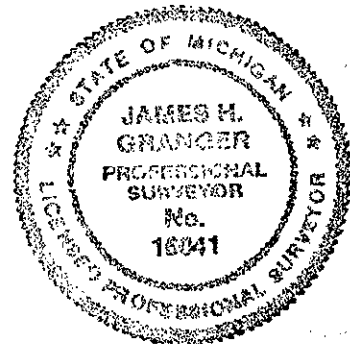

igned by James H. Granger

Date 10/23/95

urveyor's Michigan License No. 16041