

JAN 23 1996

CHEBOYGAN COUNTY REMONUMENTATION LAND CORNER RECORDATION CERTIFICATE

COMMISSION Filing Requirement of Act 74, Mich. P.A. 1970

For corners in

Cheboygan

(County)

Located In:

Corner Code =#

1. Public Land Survey

T 37N R 2W

K-7

T R

T R

T R

2. Property Controlling in Section

S T R

S T R

3. Miscellaneous Property in Sec.

S T R

S T R

4. Lot No. , Recorded Plat

5. Private Claims

RECEIVED FOR RECORD

95 DEC 11 PM 4:19

James H. Granger
CLERK/REGISTER
CHEBOYGAN COUNTY, MICHIGAN

Register of Deeds Stamp & File Number

	A	B	C	D	E	F	G	H	I	J	K	L	M
2	6		5		4		3		2				
3													
4	7		8		9		10		11		12		
5													
6	18		17		16		15		14		13		
7													
8	19		20		21		22		23		24		
9													
10	30		29		28		27		26		25		
11													
12	31		32		33		34		35		36		
13													

I, James H. Granger, in a field survey on August 4, 1995, do hereby certify that under requirements of P.A. 74, Michigan P.A. of 1970, the corner points mentioned in lines 1 and 2 above were in conformance with regulations and rules therefore as required in the current manual of survey instructions of the United States Department of the Interior, Bureau of Land Management or by a decree of a Court of Law and/or that the corner points mentioned in lines 3, 4 and 5 above were in conformance with the rules of the Michigan Board of Land Surveyors or by a Decree of a Court of Law; established, re-established, monumented, re-monumented, recovered, found as expressed below:

NOTE: Not more than 4 corners, all in the same town and range, may be recorded on this certificate.

A. Description of original monument and accessories and/or subsequent restoration:

1840 Original Survey Set wood post: 9" Cedar N72 1/2°E 451ks 10" Elm N29°W 141ks
John Mullett


1900 Co. Surveyor
1980 Survey Orlando Doyle #7319
1985 Survey Orlando Doyle #7319
1987 Survey James H. Granger # 16041 R.R. spike
1988 LCRC James H. Granger # 16041 R.R. spike

B. Description of corner evidence found and/or method applied in restoring or reestablishing corner:

Found railroad spike. Replaced with 5/8" rebar and remonumentation cap in monument box.

LIBER 010 PAGE 121


James H. Granger

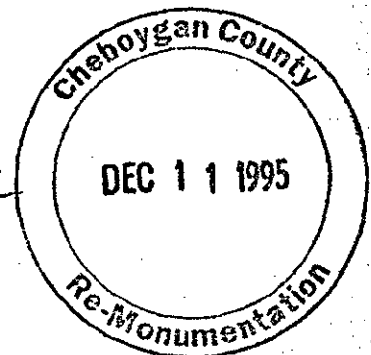

C. Description of monument for corner and accessories established to perpetuate locating the position of the corner:

5/8" rebar and remonumentation cap in monument box

Fence post N51°E 42.15 Fd tag
18" Poplar S45°E 35.30 Fd tag
Fence post N15°W 109.12 Fd tag
Stop sign post N32°E 99.50 Fd tag

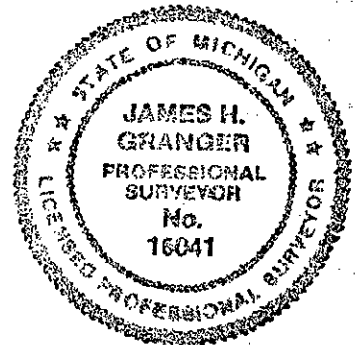

Signed by James H. Granger

Date 10/23/95

Surveyor's Michigan License No. 16041