

JAN 28 1996

CHEBOYGAN COUNTY REMONUMENTATION  
LAND CORNER RECORDATION CERTIFICATE  
Filing Requirement of Act 74, Mich. P.A. 1970

RECEIVED  
FOR RECORD

95 DEC 11 PM 4:20

*Joanna Spray*  
CLERK/REGISTER  
CHEBOYGAN COUNTY, MICHIGAN

Register of Deeds Stamp & File Number

For corners in

Cheboygan  
(County)

Located In:

Corner Code #

1. Public Land Survey	T	<u>37N</u>	R	<u>2W</u>	<u>K-8</u>
	T	_____	R	_____	_____
	T	_____	R	_____	_____
	T	_____	R	_____	_____
2. Property Controlling in Section	S	_____	T	_____	R
	S	_____	T	_____	R
3. Miscellaneous Property in Sec.	S	_____	T	_____	R
	S	_____	T	_____	R

4. Lot No. \_\_\_\_\_, Recorded Plat \_\_\_\_\_  
5. Private Claims \_\_\_\_\_

	A	B	C	D	E	F	G	H	I	J	K	L	M
2	6	5	4	3	2	1							
3													
4	7	8	9	10	11	12							
5													
6	18	17	16	15	14	13							
7													
8	19	20	21	22	23	24							
9													
10	30	29	28	27	26	25							
11													
12	31	32	33	34	35	36							
13													

I, James H. Granger, in a field survey on August 4, 19 95, do hereby certify that under requirements of P.A. 74, Michigan P.A. of 1970, the corner points mentioned in lines 1 and 2 above were in conformance with regulations and rules therefore as required in the current manual of survey instructions of the United States Department of the Interior, Bureau of Land Management or by a decree of a Court of Law and/or that the corner points mentioned in lines 3, 4 and 5 above were in conformance with the rules of the Michigan Board of Land Surveyors or by a Decree of a Court of Law; established, re-established, monumented, re-monumented, recovered, found as expressed below:

**NOTE: Not more than 4 corners, all in the same town and range, may be recorded on this certificate.**

A. Description of original monument and accessories and/or subsequent restoration:

1840 Original Survey Set wood post 10" Birch S65°E 201ks 8" Birch S88°W 231ks  
John Mullett


1900 Co. Surveyor  
1962 MDOT N.A. Koivisto 1 1/4" pipe  
1964 LCRC Kenneth Larson #10695 1 1/4" pipe  
1988 LCRC James H. Granger # 16041 3/4" pipe

B. Description of corner evidence found and/or method applied in restoring or reestablishing corner:

Found 3/4" pipe in monument box. Replaced with 5/8" rebar and remonumentation cap.

LIBER 010 PAGE 122


*Morris A. Pass*

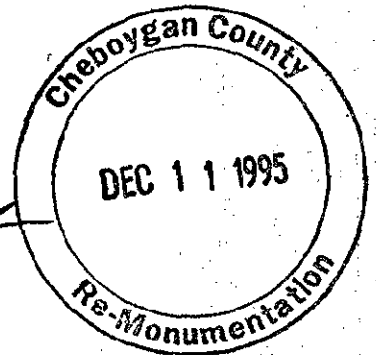

C. Description of monument for corner and accessories established to perpetuate locating the position of the corner:

5/8" rebar and remonumentation cap in monument box.

Power pole	N32°W	37.07	Fd tag
8" Maple	N38°E	67.70	Fd tag
6" Pine	N67°E	90.13	Fd tag
Power pole	S16°W	130.23	Set nail w/tag

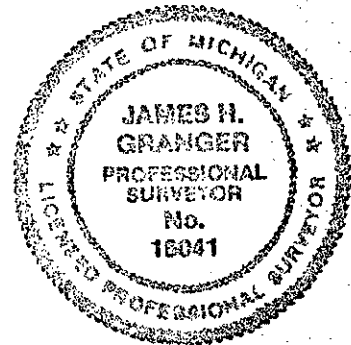

igned by James H. Granger

Date 10/23/95

urveyor's Michigan License No. 16041