

SURVEY & MONUMENTATION

JAN 23 1996

**CHEBOYGAN COUNTY REMONUMENTATION
LAND CORNER RECORDATION CERTIFICATE
Filing Requirement of Act 74, Mich. P.A. 1970**

For corners in
Cheboygan
(County)

COMMISSION

Located In: Corner Code #

- | | | | | | |
|------------------------------------|---|-----|---|----|------|
| 1. Public Land Survey | T | 37N | R | 2W | K-10 |
| | T | | R | | |
| | T | | R | | |
| | T | | R | | |
| 2. Property Controlling in Section | S | | T | R | |
| | S | | T | R | |
| 3. Miscellaneous Property in Sec. | S | | T | R | |
| | S | | T | R | |
4. Lot No. _____, Recorded Plat _____
5. Private Claims _____

RECEIVED FOR RECORD
95 DEC 11 PM 4:22
James H. Granger
CLERK/REGISTER
CHEBOYGAN COUNTY, MICHIGAN

Register of Deeds Stamp & File Number

| A | B | C | D | E | F | G | H | I | J | K | L | M |
|----|----|----|----|----|----|----|---|---|---|---|---|---|
| 2 | 6 | 5 | 4 | 3 | 2 | 1 | | | | | | |
| 3 | | | | | | | | | | | | |
| 4 | 7 | 8 | 9 | 10 | 11 | 12 | | | | | | |
| 5 | | | | | | | | | | | | |
| 6 | 13 | 17 | 16 | 15 | 14 | 13 | | | | | | |
| 7 | | | | | | | | | | | | |
| 8 | 19 | 20 | 21 | 22 | 23 | 24 | | | | | | |
| 9 | | | | | | | | | | | | |
| 10 | 30 | 29 | 28 | 27 | 26 | 25 | | | | | | |
| 11 | | | | | | | | | | | | |
| 12 | 31 | 32 | 33 | 34 | 35 | 36 | | | | | | |
| 13 | | | | | | | | | | | | |

I, James H. Granger in a field survey on August 4, 19 95, do hereby certify that under requirements of P.A. 74, Michigan P.A. of 1970, the corner points mentioned in lines 1 and 2 above were in conformance with regulations and rules therefore as required in the current manual of survey instructions of the United States Department of the Interior, Bureau of Land Management or by a decree of a Court of Law and/or that the corner points mentioned in lines 3, 4 and 5 above were in conformance with the rules of the Michigan Board of Land Surveyors or by a Decree of a Court of Law; established, re-established, monumented, re-monumented, recovered, found as expressed below:

NOTE: Not more than 4 corners, all in the same town and range, may be recorded on this certificate.

A. Description of original monument and accessories and/or subsequent restoration:

1840 Original Survey Set wood post 10" Beach S52°W 7 lks 10" Cedar S54°1/2°E 11 lks
John Mullett


- | | |
|--|--|
| 1972 Survey Orlando Doyle # 7319 | 1993 Survey James H. Granger # 16041 R.R. spil |
| 1975 Survey Orlando Doyle # 7319 | 1995 Survey James H. Granger # 16041 R.R. spil |
| 1988 LCRC James H. Granger # 16041 3/4"rod | |
| 1988 Survey James H. Granger # 16041 3/4"rod | |
| 1988 Survey James H. Granger # 16041 3/4"rod | |
| 1992 LCRC Norman Quaine # 33984 R.R. spike | |

B. Description of corner evidence found and/or method applied in restoring or reestablishing corner:

Found railroad spike. Replaced with 5/8" rebar and remonumentation cap.

LIBER 010 PAGE 124


Marvin A. Ross

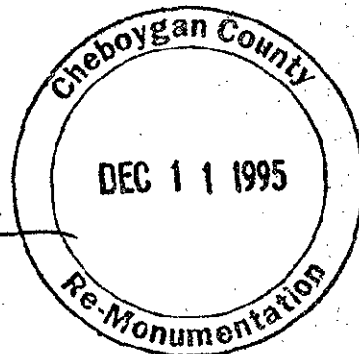

C. Description of monument for corner and accessories established to perpetuate locating the position of the corner:

5/8" rebar and remonumentation cap in Monument Box.

- | | | | |
|------------|--------|-------|--------|
| Power Pole | S 24°E | 37.99 | Fd tag |
| Power Pole | N 12°W | 90.62 | Fd tag |
| Power Pole | N 21°E | 75.78 | Fd tag |
| Power Pole | S 28°W | 61.88 | Fd tag |

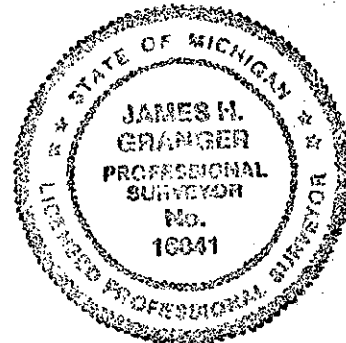

Signed by James H. Granger

Date 10/23/95

Surveyor's Michigan License No. 16041