

CHEBOYGAN COUNTY REMONUMENTATION CORNER

LAND CORNER RECORDATION CERTIFICATE  
Filing Requirement of Act 74, Mich. P.A. 1970

For corners in

CHEBOYGAN Located In: Corner Code #  
(County)

1. Public Land Survey T 37NR 2W L-3  
T R  
T R  
T R  
T R

2. Property Controlling S T R  
in Section S T R

3. Miscellaneous S T R  
Property in Sec. S T R

RECEIVED FOR RECORD 12-18-97  
at 11:41 O'Clock A M

*Joanne Spray*

CLERK/REGISTER  
CHEBOYGAN COUNTY, MICHIGAN

Register of Deeds Stamp & File Number

4. Lot No. \_\_\_\_\_, Recorded Plat \_\_\_\_\_  
5. Private Claims \_\_\_\_\_

JAMES H. GRANGER, in a field survey on JULY 15, 19 97 do hereby state that under requirements of P.A. 74, Michigan P.A. of 1970, the corner points mentioned in lines 1 and 2 above were in conformance with regulations and rules therefore as required in the current manual of survey instructions of the United States Department of the Interior, Bureau of Land Management or by a decree of a Court of Law and for that the corner points mentioned in lines 3, 4 and 5 above were in conformance with the rules of the Michigan Board of Land Surveyors or by a Decree of a Court of Law; established, re-established, monumented, recovered, found as expressed below:

NOTE: Not more than 2 corners, all in the same town and range, may be recorded on this certificate.


A. Description of original monument and accessories and/or subsequent restoration:

--3 1855 Original Survey Set wood post 18" W. Pine S49°E 18 lks  
Harvey Meilen 20" W. Pine N32°W 20 lks

1991 Survey 1" pipe  
James H. Granger #16041

1991 LCRC 1" pipe  
James H. Granger #16041

SURVEY &  
REMONUMENTATION  
FEB 26 1998  
SECTION

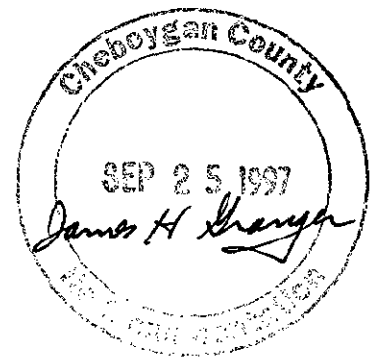

	A	B	C	D	E	F	G	H	I	J	K	L	M
1													
2	6		5		4		3		2		1		
3													
4	7		8		9		10		11		12		
5													
6	18		17		16		15		14		13		
7													
8	19		20		21		22		23		24		
9													
10	30		29		28		27		26		25		
11													
12	31		32		33		34		35		36		
13													

B. Description of corner evidence found and/or method applied in restoring or reestablishing corner:


--3 Found 1" pipe and 4 witnesses from 1991 LCRC. Set 5/8" rebar and remonumentation cap inside pipe.

C. Description of monument for corner and accessories established to perpetuate locating the position of the corner:

--3 5/8" rebar and Remonumentation Cap inside pipe  
Fence post N 0°E 10.65' Fd tag #16041  
Fence post N34°E 4.20' Fd tag #16041  
Fence post N89°E 3.45' Fd tag #16041  
Fence post S89°W 2.12' Fd tag #16041

Signed by James H. Granger  
License No. 16041

Date Nov 17, 1997 Surveyor's Michigan

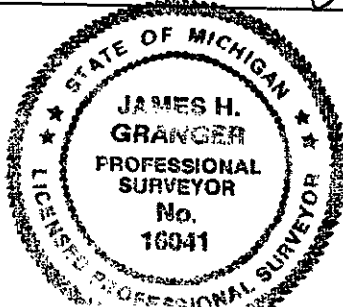

FORM APPROVED BY MICHIGAN STATE BOARD OF PROFESSIONAL SURVEYORS, JAN. 23, 1971  
REVISED 14, 1975

REVISED JAN., 1983  
REVISED OCT., 1986