

SURVEY & MONUMENTATION

JAN 23 1996

CHEBOYGAN COUNTY REMONUMENTATION LAND CORNER RECORDATION CERTIFICATE

Filing Requirement of Act 74, Mich. P.A. 1970

For corners in

COMMISSION

Cheboygan

(County)

Located In:

Corner Code #

- | | | | | | |
|------------------------------------|---|------------|---|-----------|------------------|
| 1. Public Land Survey | T | <u>37N</u> | R | <u>2W</u> | <u>K-11 M.C.</u> |
| | T | _____ | R | _____ | <u>1</u> |
| | T | _____ | R | _____ | _____ |
| | T | _____ | R | _____ | _____ |
| 2. Property Controlling in Section | S | _____ | T | _____ | _____ |
| | S | _____ | T | _____ | _____ |
| 3. Miscellaneous | S | _____ | T | _____ | _____ |
| Property in Sec. | S | _____ | T | _____ | _____ |

RECEIVED FOR RECORD

95 DEC 11 PM 4: 25

James H. Granger
CLERK/REGISTER
CHEBOYGAN COUNTY, MICHIGAN

Register of Deeds Stamp & File Number

4. Lot No. _____, Recorded Plat _____
5. Private Claims _____

I, James H. Granger, in a field survey on August 4, 1995, do hereby certify that under requirements of P.A. 74, Michigan P.A. of 1970, the corner points mentioned in lines 1 and 2 above were in conformance with regulations and rules therefore as required in the current manual of survey instructions of the United States Department of the Interior, Bureau of Land Management or by a decree of a Court of Law and/or that the corner points mentioned in lines 3, 4 and 5 above were in conformance with the rules of the Michigan Board of Land Surveyors or by a Decree of a Court of Law; established, re-established, monumented, re-monumented, recovered, found as expressed below:

NOTE: Not more than 4 corners, all in the same town and range, may be recorded on this certificate.

	A	B	C	D	E	F	G	H	I	J	K	L	M
2	6	5	4	3	2	1							
3													
4	7	8	9	10	11	12							
5													
6	18	17	16	15	14	13							
7													
8	19	20	21	22	23	24							
9													
10	30	29	28	27	26	25							
11													
12	31	32	33	34	35	36							
13													

A. Description of original monument and accessories and/or subsequent restoration:

- 1840 Original Survey Set wood post 7" B. Oak S78°E 20 lks 12" sugar S30 1/2°W 53 lks
- 1893 Subdivision Geo. Sinclair
- 1910 Subdivision W.R. Middleton
- 1988 Survey James H. Granger # 16041


B. Description of corner evidence found and/or method applied in restoring or reestablishing corner:

Meander Corner

Found 1/2" rebar with cap # 16041. Set remonumentation cap on 1/2" rebar in monument box.

LIBER **010** PAGE **125**

Marvin B...

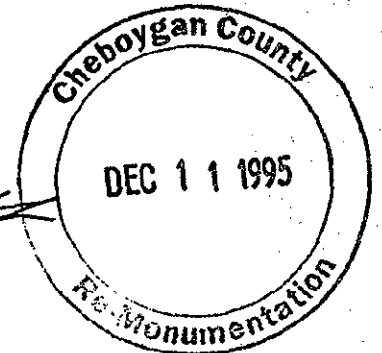


C. Description of monument for corner and accessories established to perpetuate locating the position of the corner:

Meander Corner

remonumentation cap on 1/2" rebar in monument box.

- | | | | |
|------------|-------|-------|-----------|
| Power Pole | S28°W | 61.20 | Found tag |
| Power Pole | N6°W | 93.46 | Found Tag |
| Power Pole | N25°E | 40.66 | Found Tag |
| Power Pole | S2°E | 65.70 | Found Tag |

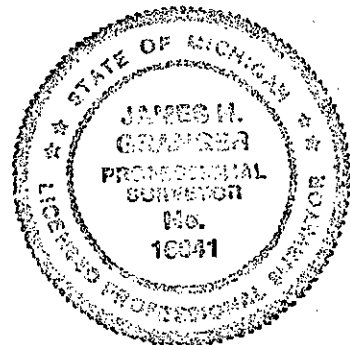

Signed by James H. Granger

Date 10/23/95

Surveyor's Michigan License No. 16041