

SURVEY &  
REMONUMENTATION

1993

COMMISSION

CHEBOYGAN COUNTY REMONUMENTATION CORNER  
LAND CORNER RECORDATION CERTIFICATE  
Filing Requirement of Act 74, Mich. P.A. 1970

For corners in

CHEBOYGAN (County)	Located In:	Corner Code #
1. Public Land Survey	T 38N R 1E	A-10
	T _____ R _____	_____
	T _____ R _____	_____
	T _____ R _____	_____
2. Property Controlling in Section	S _____ T _____ R _____	_____
	S _____ T _____ R _____	_____
3. Miscellaneous Property in Sec.	S _____ T _____ R _____	_____
	S _____ T _____ R _____	_____
4. Lot No. _____, Recorded Plat _____		
5. Private Claims _____		

RECEIVED  
FOR RECORD  
93 DEC 22 AM 9:49  
*James Gray*  
CLERK/REGISTER  
CHEBOYGAN COUNTY, MICHIGAN  
Register of Deeds Stamp & File Number

I, Ronald R. Bischer, in a field survey on September 24, 19 93, do hereby certify that under requirements of P.A. 74, Michigan P.A. of 1970, the corner points mentioned in lines 1 and 2 above were in conformance with regulations and rules therefore as required in the current manual of survey instructions of the United States Department of the Interior, Bureau of Land Management or by a decree of a Court of Law and/or that the corner points mentioned in lines 3, 4 and 5 above were in conformance with the rules of the Michigan Board of Land Surveyors or by a Decree of a Court of Law; established, re-established, monumented, re-monumented, recovered, found as expressed below:

	A	B	C	D	E	F	G	H	I	J	K	L	M
2	6		5		4		3		2		1		
3													
4	7		8		9		10		11		12		
5													
6	18		17		16		15		14		13		
7													
8	19		20		21		22		23		24		
9													
10	30		29		28		27		26		25		
11													
12	31		32		33		34		35		36		
13													

**NOTE: Not more than 4 corners, all in the same town and range, may be recorded on this certificate.**

A. Description of original monument and accessories and/or subsequent restoration:

A-10  
Original Survey - June 1840  
John Hodgson  
10" Cedar for 1/4 Corner Post  
20 chains North to 14 link stream  
1948 - Joseph Doyle  
Found 1" Pipe  
14" Pine S00°30'E 36.10'  
Conc. R.O.W. Marker N05°E 9.58'

4" Birch N73°W 20.74'  
1957 - Orlando Doyle  
Found 1" Pipe & used witnesses from above  
1972 - Orlando Doyle  
Found 1" Pipe & used witnesses from above

B. Description of corner evidence found and/or method applied in restoring or reestablishing corner:

A-10  
Found 1" Pipe  
Concrete R.O.W. Marker N05°E 9.58'  
14" Pine S00°30'E 36.10'  
stump remains  
4" Birch N73°W 20.74'  
gone

LIBER 010 PAGE 16



Stream is 20 chains (1320') North of corner.

Replaced 1" Pipe with Cheboygan County Remonumentation Monument.

C. Description of monument for corner and accessories established to perpetuate locating the position of the corner:

A-10  
Cheboygan County Remonumentation Monument  
N05°E 9.58' R.O.W. Marker  
N53°W 7.66' 6" Balsam  
S52°E 7.52' 4" Balsam  
N77°W 31.95' 6" Ash

Set nail with witness tag #22428 in witnesses.

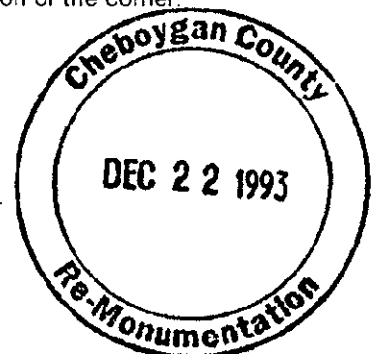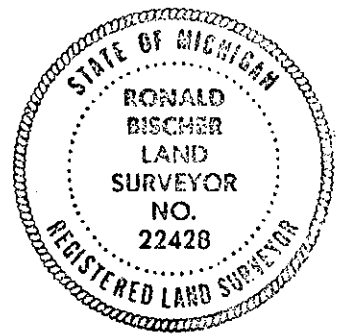

Signed by Ronald R. Bischer

Date 12-03-93

Surveyor's Michigan License No. 22428