

**SURVEY & REMONUMENTATION**

1993

**CHEBOYGAN COUNTY REMONUMENTATION CORNER  
LAND CORNER RECORDATION CERTIFICATE  
Filing Requirement of Act 74, Mich. P.A. 1970**

**COMMISSION**

For corners in

CHEBOYGAN (County)	Located In:	Corner Code #
1. Public Land Survey	T 38N R 1E	A-11
	T _____ R _____	_____
	T _____ R _____	_____
	T _____ R _____	_____
2. Property Controlling in Section	S _____ T _____ R _____	_____
	S _____ T _____ R _____	_____
3. Miscellaneous Property in Sec.	S _____ T _____ R _____	_____
	S _____ T _____ R _____	_____
4. Lot No. _____, Recorded Plat _____		
5. Private Claims _____		

RECEIVED  
FOR RECORD  
93 DEC 22 AM 11:06  
*James Spray*  
CLERK/REGISTER  
CHEBOYGAN COUNTY, MICHIGAN

Register of Deeds Stamp & File Number


	A	B	C	D	E	F	G	H	I	J	K	L	M
2	6	5	4	3	2	1							
3													
4	7	8	9	10	11	12							
5													
6	18	17	16	15	14	13							
7													
8	19	20	21	22	23	24							
9													
10	30	29	28	27	26	25							
11	•												
12	31	32	33	34	35	36							
13													

I, Ronald R. Bischer, in a field survey on September 24, 19 93, do hereby certify that under requirements of P.A. 74, Michigan P.A. of 1970, the corner points mentioned in lines 1 and 2 above were in conformance with regulations and rules therefore as required in the current manual of survey instructions of the United States Department of the Interior, Bureau of Land Management or by a decree of a Court of Law and/or that the corner points mentioned in lines 3, 4 and 5 above were in conformance with the rules of the Michigan Board of Land Surveyors or by a Decree of a Court of Law; established, re-established, monumented, re-monumented, recovered, found as expressed below:

**NOTE: Not more than 4 corners, all in the same town and range, may be recorded on this certificate.**

A. Description of original monument and accessories and/or subsequent restoration:

A-11  
Original Survey - June 1840  
John Hodgson set Wood Post  
8" Hemlock N36°W 8 links  
22" Pine S23°E 20 links  
1948 - Joseph Doyle  
Found 3/4" Pipe  
6" Poplar N39°30'W 40.00'  
6" Poplar S62°30'W 34.70'  
1967 - Kenneth Ostling  
Found 1" Iron Pipe - replaced with Conservation  
Department Monument  
5" H. Maple N36°W 21.05'  
4" H. Maple N73°E 28.25'  
10" Aspen S64°E 19.95'  
7" H. Maple S49°W 26.5'  
1970 - Orlando Doyle  
found & used Conservation Monument

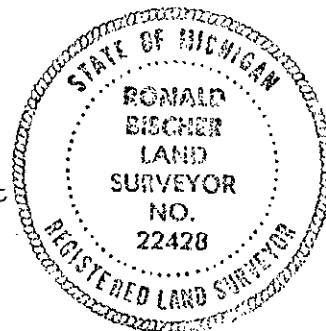

B. Description of corner evidence found and/or method applied in restoring or reestablishing corner:

A-11  
Found Conservation Department Monument by 1" pipe  
N39°30'W 40.00' Aspen stump  
(J. Doyle witness)  
N36°W 21.05' 6" Maple  
chest blaze - Conservation Dept. witness


Road construction and clear cut destroyed all other witnesses.

LIBER 010 PAGE 30

Description of monument for corner and accessories established to perpetuate locating the position of the corner:

A-11  
Conservation Department Monument  
N36°W 21.05' 6" Maple  
N78°E 14.90' 11" Maple  
S25°E 18.09' 7" Maple  
S23°W 18.85' 6" Maple

*Monument Restored*

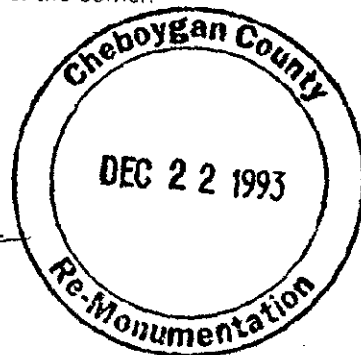

Recorded by Ronald R. Bischer

Date 12-03-93

Surveyor's Michigan License No. 22428