

SURVEY & REMONUMENTATION

Benton

1993

102

COMMISSION

**CHEBOYGAN COUNTY REMONUMENTATION CORNER
LAND CORNER RECORDATION CERTIFICATE
Filing Requirement of Act 74, Mich. P.A. 1970**

For corners in

CHEBOYGAN (County)	Located In:	Corner Code #
1. Public Land Survey	T <u>38N</u> R <u>1E</u>	<u>A-12</u>
	T _____ R _____	_____
	T _____ R _____	_____
	T _____ R _____	_____
2. Property Controlling in Section	S _____ T _____ R _____	_____
	S _____ T _____ R _____	_____
3. Miscellaneous Property in Sec.	S _____ T _____ R _____	_____
	S _____ T _____ R _____	_____

RECEIVED
FOR RECORD
93 DEC 22 AM 10:59

Joanna Gray
CLERK/REGISTER
CHEBOYGAN COUNTY, MICHIGAN

Register of Deeds Stamp & File Number

4. Lot No. _____, Recorded Plat _____
5. Private Claims _____

	A	B	C	D	E	F	G	H	I	J	K	L	M
2	6		5		4		3		2				
3													
4	7		8		9		10		11		12		
5													
6	18		17		16		15		14		13		
7													
8	19		20		21		22		23		24		
9													
10	30		29		28		27		26		25		
11													
12	31		32		33		34		35		36		
13													


I, Ronald R. Bischer, in a field survey on September 24, 19 93, do hereby certify that under requirements of P.A. 74, Michigan P.A. of 1970, the corner points mentioned in lines 1 and 2 above were in conformance with regulations and rules therefore as required in the current manual of survey instructions of the United States Department of the Interior, Bureau of Land Management or by a decree of a Court of Law and/or that the corner points mentioned in lines 3, 4 and 5 above were in conformance with the rules of the Michigan Board of Land Surveyors or by a Decree of a Court of Law; established, re-established, monumented, re-monumented, recovered, found as expressed below:

NOTE: Not more than 4 corners, all in the same town and range, may be recorded on this certificate.

A. Description of original monument and accessories and/or subsequent restoration:

A-12
Original Survey - June 1840
John Hodgson set Wood Post
10" Beech S42 W 21 links
7" Beech S10 E 19 links
1967 - Kenneth Ostling
Set Conservation Dept. Monument
by proportionate measurement.

S15°E 43.9' 7" R. Pine
N73°E 67.9' 6" W. Birch

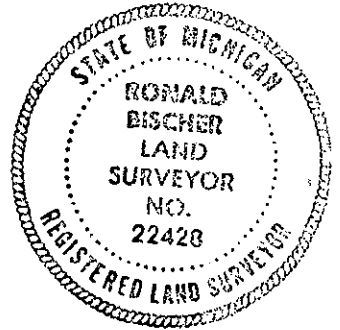

B. Description of corner evidence found and/or method applied in restoring or reestablishing corner:

A-12
Conservation Department Monument found
S15°E 44.09' 10" Red Pine
Conservation Dept. foot blaze & chest blaze
N73°W 68.05' 8" White Birch
Conservation Dept. foot blaze & chest blaze


Monument agrees with single proportion measurement made on September 24, 1993.

LIBER 010 PAGE 29

C. Description of monument for corner and accessories established to perpetuate locating the position of the corner:

A-12
Conservation Department Monument
S15°E 44.09' 10" Red Pine
N73°W 68.05' 8" White Birch
S37°W 50.33' 12" Red Oak
S80°E 23.18' 7" White Birch
N13°E 25.59' 5" Maple

Marvin A. Fox

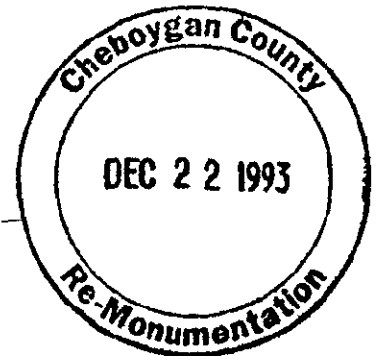

Set nail with witness tag #22428 in witnesses.

Signed by Ronald R. Bischer Date 12-03-93

Surveyor's Michigan License No. 22428