

MICHIGAN
DEPARTMENT OF CONSERVATION
FORESTRY DIVISION

LAND CORNER RECORD


T. 38 N.R. 1 E
T. 38 N.R. 1 W
Cheboygan COUNTY

DESCRIPTION OF CORNER Section Corner common to Sections 25-30-31-36

CORNER MONUMENT Set Cons. Dept. Monument

DATE MONUMENT PLACED AND WITNESSED 7/3/67

WITNESSES TO CORNER.....

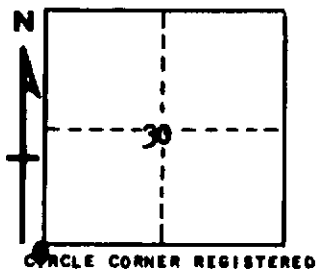

5" H. Maple	N 36 W	21.05'
4" H. Maple	N 73 E	28.25'
10" Aspen	S 64 E	19.95'
Tdn 7" H. Maple	S 49 W	26.5'

AND

CORNER REGISTERED

DESCRIPTION IN DETAIL AS TO HOW CORNER WAS LOCATED AND IDENTIFIED OR RESTORED.

This corner was found while making partial survey at T38N, R1W. Perpetuated corner as previously set by unknown surveyor. Probable original witness stump in place. Fits swamp edges East - West. Old rotted and burned wood stakes beside 1" iron pipe, appears very old.

SURVEYOR'S SEAL

SIGNED Kenneth W. Pitting DATE 8/28/67
REGISTERED LAND SURVEYOR #10068