

SURVEY & REMONUMENTATION

MAY 03 1995

**CHEBOYGAN COUNTY REMONUMENTATION
LAND CORNER RECORDATION CERTIFICATE
COMMISSION Filing Requirement of Act 74, Mich. P.A. 1970**

RECEIVED FOR RECORD

94 NOV 22 AM 10:14

James H. Granger
CLERK/REGISTER
CHEBOYGAN COUNTY, MICHIGAN

For corners in

Cheboygan
(County)

Located In:

Corner Code #

1. Public Land Survey	T	38N	R	1W	B-11
	T		R		
	T		R		
	T		R		
2. Property Controlling in Section	S		T	R	
	S		T	R	
3. Miscellaneous Property in Sec.	S		T	R	
	S		T	R	

Register of Deeds Stamp & File Number

4. Lot No. _____, Recorded Plat _____
5. Private Claims _____

	A	B	C	D	E	F	G	H	I	J	K	L	M
2	6	5	4	3	2	1							
3													
4	7	8	9	10	11	12							
5													
6	18	17	16	15	14	13							
7													
8	19	20	21	22	23	24							
9													
10	30	29	28	27	26	25							
11													
12	31	32	33	34	35	36							
13													

I, James H. Granger, in a field survey on August 15, 19 94, do hereby certify that under requirements of P.A. 74, Michigan P.A. of 1970, the corner points mentioned in lines 1 and 2 above were in conformance with regulations and rules therefore as required in the current manual of survey instructions of the United States Department of the Interior, Bureau of Land Management or by a decree of a Court of Law and/or that the corner points mentioned in lines 3, 4 and 5 above were in conformance with the rules of the Michigan Board of Land Surveyors or by a Decree of a Court of Law; established, re-established, monumented, re-monumented, recovered, found as expressed below:

NOTE: Not more than 4 corners, all in the same town and range, may be recorded on this certificate.


1. Description of original monument and accessories and/or subsequent restoration:

1855 Original Survey Set wood post 12" Cedar S48°E 55 lks, 6" Elm S60°W 27 lks Harvey Mellen

2. Description of corner evidence found and/or method applied in restoring or reestablishing corner:

Placed 5/8" rebar w/ aluminum cap in monument box. Positioned corner by prorating GLO distance from NW sec corner to NE sec corner and fitting deflection of section line per GLO notes.


Monument Restored

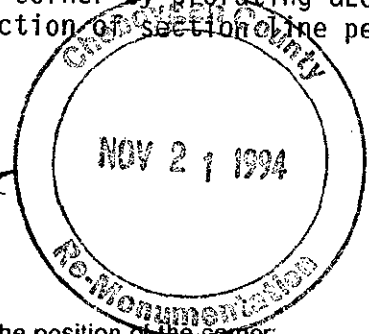

3. Description of monument for corner and accessories established to perpetuate locating the position of the corner:

PP N81°E 136.85'
PP S70°E 91.66'
PP S87°W 143.20'
PP N70°W 140.98'

5/8" rebar w/aluminum cap in Monument Box

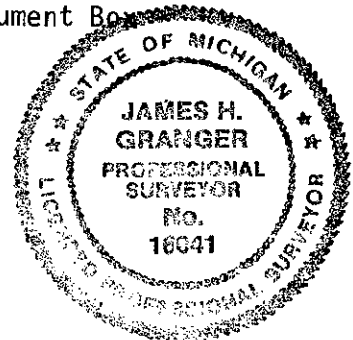

LIBER 010 PAGE 64

signed by James H. Granger
Surveyor's Michigan License No. 16041

Date 11-18-94