

SURVEY & REMONUMENTATION

CHEBOYGAN COUNTY REMONUMENTATION

RECEIVED FOR RECORD

MAY 03 1995

94 NOV 22 AM 9:46

COMMISSION

LAND CORNER RECORDATION CERTIFICATE
Filing Requirement of Act 74, Mich. P.A. 1970

For corners in

Cheboygan

(County)

Located In:

Corner Code #

| | | | | | |
|------------------------------------|---|-----|---|----|------|
| 1. Public Land Survey | T | 38N | R | 1W | C-11 |
| | T | | R | | |
| | T | | R | | |
| | T | | R | | |
| 2. Property Controlling in Section | S | | T | R | |
| | S | | T | R | |
| 3. Miscellaneous Property in Sec. | S | | T | R | |
| | S | | T | R | |

James H. Granger
CLERK/REGISTER
CHEBOYGAN COUNTY, MICHIGAN

Register of Deeds Stamp & File Number

4. Lot No. _____, Recorded Plat _____
5. Private Claims _____

| A | B | C | D | E | F | G | H | I | J | K | L | M |
|----|----|----|----|----|----|----|---|---|---|---|---|---|
| 2 | 6 | 5 | 4 | 3 | 2 | 1 | | | | | | |
| 3 | | | | | | | | | | | | |
| 4 | 7 | 8 | 9 | 10 | 11 | 12 | | | | | | |
| 5 | | | | | | | | | | | | |
| 6 | 18 | 17 | 16 | 15 | 14 | 13 | | | | | | |
| 7 | | | | | | | | | | | | |
| 8 | 19 | 20 | 21 | 22 | 23 | 24 | | | | | | |
| 9 | | | | | | | | | | | | |
| 10 | 30 | 29 | 28 | 27 | 26 | 25 | | | | | | |
| 11 | | | | | | | | | | | | |
| 12 | 31 | 32 | 33 | 34 | 35 | 36 | | | | | | |
| 13 | | | | | | | | | | | | |

I, James H. Granger, in a field survey on August 15, 19 94, do hereby certify that under requirements of P.A. 74, Michigan P.A. of 1970, the corner points mentioned in lines 1 and 2 above were in conformance with regulations and rules therefore as required in the current manual of survey instructions of the United States Department of the Interior, Bureau of Land Management or by a decree of a Court of Law and/or that the corner points mentioned in lines 3, 4 and 5 above were in conformance with the rules of the Michigan Board of Land Surveyors or by a Decree of a Court of Law; established, re-established, monumented, re-monumented, recovered, found as expressed below:


NOTE: Not more than 4 corners, all in the same town and range, may be recorded on this certificate.

A. Description of original monument and accessories and/or subsequent restoration:

- 1855 Original Survey Set wood post, S 53½°W 60 lks Harvey Mellen
- 1858 O.S. Hayden Plat Monument
- 1896 W.C. Thompson Plat Monument
- 1956 Orlando Doyle #7319 Fd 1" Axle

B. Description of corner evidence found and/or method applied in restoring or reestablishing corner:

Fd 1" axle. Reset 5/8" rebar w/ aluminum cap in Monument Box. Placed 4 new witnesses.

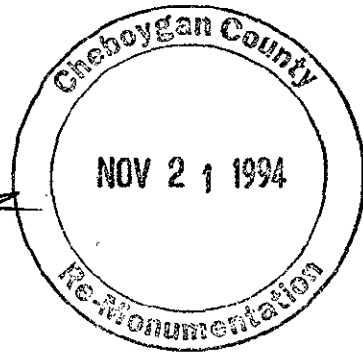


Monumental Record

C. Description of monument for corner and accessories established to perpetuate locating the position of the corner:

- 5/8" rebar w/aluminum cap in Monument Box
- PP S 28°W 8.52'
- NE cor Bldg N 85°W 20.29'
- 8" Birch N 13°W 22.55'
- SE cor Bldg N 21°E 36.15'

LIBER 010 PAGE 51

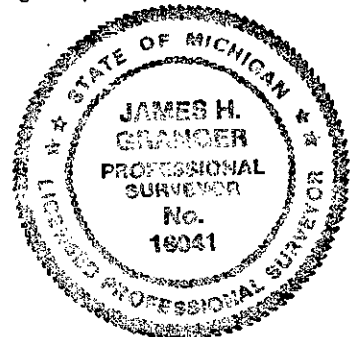

Signed by James H. Granger
Surveyor's Michigan License No. 18041

Date 11-10-94