

MICHIGAN
DEPARTMENT OF CONSERVATION
FORESTRY DIVISION

LAND CORNER RECORD

T. 38 N.R. E W


Cheboygan COUNTY

DESCRIPTION OF CORNER Section corner common to Sections 25-26-35-36

CORNER MONUMENT Set Cons. Dept. Mon.

DATE MONUMENT PLACED AND WITNESSED 8/16/67

WITNESSES TO CORNER.....

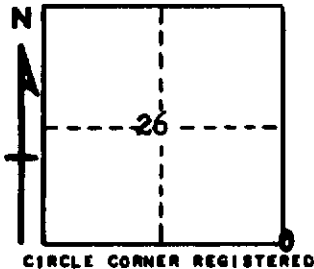

4" R. Pine N 65 W 93.0'

6" W. Pine N 15 W 87.5'

AND

DESCRIPTION IN DETAIL AS TO HOW CORNER WAS LOCATED AND IDENTIFIED OR RESTORED.

This corner was restored during a survey in this area. Reestablished corner according to records of previous surveys in this section. Checks corners north and west, and stream and swamp crossings all directions. Bowen's pipe appears to have been moved, or was originally erroneously placed.

SURVEYOR'S SEAL

SIGNED *Kenneth J. Pittman* DATE 9/20/67
REGISTERED LAND SURVEYOR #10068