

REMONUMENTATION

CHEBOYGAN COUNTY REMONUMENTATION CORNER

LAND CORNER RECORDATION CERTIFICATE  
Filing Requirement of Act 74, Mich. P.A. 1970

MAILED  
10/30/96  
COMMISSION  
For corners in  
CHEBOYGAN

(County)	Located In:	Corner Code #
1. Public Land Survey	T <u>38N</u> R <u>3W</u>	<u>M-1</u>
	T <u>38</u> R <u>2W</u>	<u>A-1</u>
	T _____ R _____	_____
2. Property Controlling in Section	S _____ T _____ R _____	_____
3. Miscellaneous Property in Sec.	S _____ T _____ R _____	_____

RECEIVED FOR RECORD  
96 OCT 30 PM 12:03  
*Joanna Spray*  
CLERK/REGISTER  
CHEBOYGAN COUNTY, MICHIGAN  
Register of Deeds Stamp & File Number

4. Lot No. \_\_\_\_\_, Recorded Plat \_\_\_\_\_  
5. Private Claims \_\_\_\_\_

A	B	C	D	E	F	G	H	I	J	K	L	M
1												
2	6	5	4	3	2	1						
3												
4	7	8	9	10	11	12						
5												
6	18	17	16	15	14	13						
7												
8	19	20	21	22	23	24						
9												
10	30	29	28	27	26	25						
11												
12	31	32	33	34	35	36						
13												


I, JAMES H. GRANGER, in a field survey on SEPTEMBER 24, 19 96 do hereby state that under requirements of P.A. 74, Michigan P.A. of 1970, the corner points mentioned in lines 1 and 2 above were in conformance with regulations and rules therefore as required in the current manual of survey instructions of the United States Department of the Interior, Bureau of Land Management or by a decree of a Court of Law and for that the corner points mentioned in lines 3, 4 and 5 above were in conformance with the rules of the Michigan Board of Land Surveyors or by a Decree of a Court of Law; established; re-established, monumented, recovered, found as expressed below:

NOTE: Not more than 2 corners, all in the same town and range, may be recorded on this certificate.

A. Description of original monument and accessories and/or subsequent restoration:

- |                                      |   |                                       |                |
|--------------------------------------|---|---------------------------------------|----------------|
| 1840 Original Survey<br>John Mullett | Set wood post 12" Fir S40°W 12 lks<br>10" Tamarack N69°E 15 lks | 1981 Survey<br>Orlando Doyle # 7319   | Metal Monument |
| 1967 Survey<br>Orlando Doyle # 7319  | Metal Monument  | 1985 Survey<br>Orlando Doyle # 7319   | Metal Monument |
| 1967 Survey<br>Orlando Doyle # 7319  | Metal Monument  | 1992 LCRC<br>James H. Granger # 16041 | Set PK Nail    |
| 1969 Survey<br>Orlando Doyle # 7319  | Metal Monument  |                                       |                |
| 1971 Survey<br>Orlando Doyle # 7319  | Metal Monument  |                                       |                |

*Marvin A. Ray*

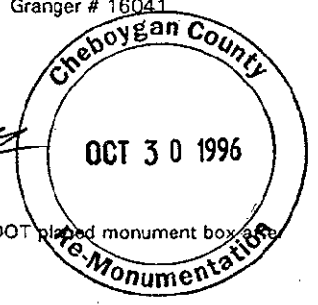

B. Description of corner evidence found and/or method applied in restoring or reestablishing corner:

Found PK nail and four witnesses. PK nail subsequently removed by MDOT repaving project. MDOT placed monument box at repaving at position from witnesses.


LIBER 010 PAGE 168

C. Description of monument for corner and accessories established to perpetuate locating the position

also corner A-1, T38N, R2W

Set 5/8" x 30" rebar with Remonumentation Cap inside monument box

9" Spruce	S05°W	75.36'	Fd tag
12" Balsam	S70°W	77.10'	Fd tag
Conc. Mon.	N08°E	79.56'	
Satellite Dish	N55°E	85.00'	
Centerline US-23	S33°W	3.3'	

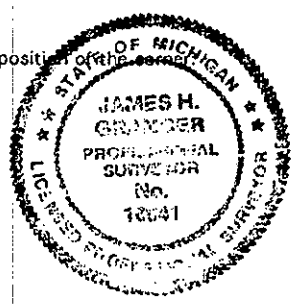

Signed by James H. Granger  
Surveyor's Michigan License No. 16041

Date 10-10-96