

MAY 05 1997

CHEBOYGAN COUNTY REMONUMENTATION CORNER

LAND CORNER RECORDATION CERTIFICATE  
Filing Requirement of Act 74, Mich. P.A. 1970

For corners in  
CHEBOYGAN

_____	Located In:	Corner Code #
(County)		
1. Public Land Survey	T <u>38N</u> R <u>3W</u>	<u>M-2</u>
	T _____ R _____	_____
	T <u>38</u> R <u>2W</u>	<u>A-2</u>
	T _____ R _____	_____
2. Property Controlling in Section	S _____ T _____ R _____	_____
	S _____ T _____ R _____	_____
3. Miscellaneous Property in Sec.	S _____ T _____ R _____	_____
	S _____ T _____ R _____	_____

RECEIVED  
FOR RECORD  
96 OCT 30 PM 12:07  
*Joanna Spray*  
CLERK/REGISTER  
CHEBOYGAN COUNTY, MICHIGAN  
Register of Deeds Stamp & File Number

4. Lot No. \_\_\_\_\_, Recorded Plat \_\_\_\_\_  
5. Private Claims \_\_\_\_\_

I, JAMES H. GRANGER, in a field survey on SEPTEMBER 24, 19 96  
do hereby state that under requirements of P.A. 74, Michigan P.A. of 1970, the corner points  
mentioned in lines 1 and 2 above were in conformance with regulations and rules therefore as  
required in the current manual of survey instructions of the United States Department of the Interior,  
Bureau of Land Management or by a decree of a Court of Law and /or that the corner points  
mentioned in lines 3, 4 and 5 above were in conformance with the rules of the Michigan Board of  
Land Surveyors or by a Decree of a Court of Law; established, re-established, monumented,  
recovered, found as expressed below:

NOTE: Not more than 2 corners, all in the same town and range, may be recorded  
on this certificate.

1	A	B	C	D	E	F	G	H	I	J	K	L	M
2	6	5	4	3	2	1							
3													
4	7	8	9	10	11	12							
5													
6	18	17	16	15	14	13							
7													
8	19	20	21	22	23	24							
9													
10	30	29	28	27	26	25							
11													
12	31	32	33	34	35	36							
13													


A. Description of original monument and accessories and/or subsequent restoration:

1840 Original Survey John Mullett	Set wood post 10" Cedar N65°E 6 lks 8" Fir S04°W 14 lks
1981 Survey Orlando Doyle # 7319	Metal Monument
1985 Survey Orlando Doyle # 7319	1" pipe

B. Description of corner evidence found and/or method applied in restoring or reestablishing corner:

Found 1" pipe in concrete monument.

*Marvin A. Ross*

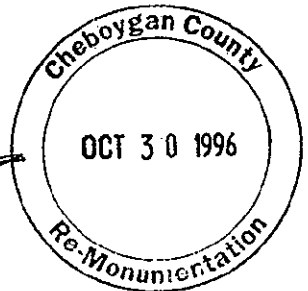


LIBER 010 PAGE 169

C. Description of monument for corner and accessories established to perpetuate locating the position of the corner:

also corner A-2, T38N, R2W

Set 5/8" x 30" rebar inside 1" pipe with Remonumentation Cap

1" Pipe			
14' Spruce	N30°W	15.60'	Set nail w/tag
12" Poplar	S57°W	6.99'	Set nail w/tag
8" Balsam	S21°E	22.35'	Set nail w/tag
8" Balsam	S62°E	23.82'	Set nail w/tag

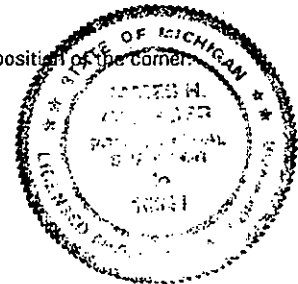

Signed by *James H. Granger*  
Surveyor's Michigan License No. 16041

Date 10-10-96