

**SURVEY
REMONUMENTATION**

MAY 9 1997

**CHEBOYGAN COUNTY REMONUMENTATION CORNER
LAND CORNER RECORDATION CERTIFICATE
Filing Requirement of Act 74, Mich. P.A. 1970**

For corners in
CHEBOYGAN

Located in:	Corner Code #
1. Public Land Survey	T <u>38N</u> R <u>3W</u> M-3
	T _____ R _____
	T <u>38</u> R <u>2W</u> <u>A-3</u>
	T _____ R _____
2. Property Controlling in Section	S _____ T _____ R _____
	S _____ T _____ R _____
3. Miscellaneous Property in Sec.	S _____ T _____ R _____
	S _____ T _____ R _____

RECEIVED FOR RECORD
96 OCT 30 PM 12:08
James H. Granger
CLERK/REGISTER
CHEBOYGAN COUNTY, MICHIGAN
Register of Deeds Stamp & File Number

4. Lot No. _____, Recorded Plat _____
5. Private Claims _____

I, JAMES H. GRANGER, in a field survey on OCTOBER 18, 19 96, do hereby state that under requirements of P.A. 74, Michigan P.A. of 1970, the corner points mentioned in lines 1 and 2 above were in conformance with regulations and rules therefore as required in the current manual of survey instructions of the United States Department of the Interior, Bureau of Land Management or by a decree of a Court of Law and /or that the corner points mentioned in lines 3, 4 and 5 above were in conformance with the rules of the Michigan Board of Land Surveyors or by a Decree of a Court of Law; established, re-established, monumented, recovered, found as expressed below:

A	B	C	D	E	F	G	H	I	J	K	L	M
1												
2	6	5	4	3	2	1						
3												
4	7	8	9	10	11	12						
5												
6	18	17	16	15	14	13						
7												
8	19	20	21	22	23	24						
9												
10	30	29	28	27	26	25						
11												
12	31	32	33	34	35	36						
13												


NOTE: Not more than 2 corners, all in the same town and range, may be recorded on this certificate.

A. Description of original monument and accessories and/or subsequent restoration:

- 1840 - Original Survey 12" Cedar at corner
John Mullett
- 1964 - DNR-LCRC Set 1" pipe w/4" brass cap
Ken Larsen #10695

B. Description of corner evidence found and/or method applied in restoring or reestablishing corner:

Found 1" pipe with 4" brass cap, one scribed witness and set four witnesses. *Marvin A. Ray*

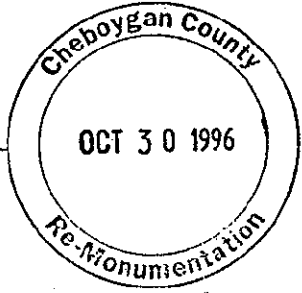

LIBER 010 PAGE 170

C. Description of monument for corner and accessories established to perpetuate locating the position of also corner A-3, T38N, R2W

- 1" pipe
- 8" Birch N 60°E 18.00'
- 6" Birch S44°E 15.89'
- 6" Birch S08°W 9.28'
- 4" Balsam N36°W 10.07'



Signed by *James H. Granger*
Surveyor's Michigan License No. 16041

Date 10-18-96