

MAY 15 1987

CHEBOYGAN COUNTY REMONUMENTATION CORNER  
LAND CORNER RECORDATION CERTIFICATE  
Filing Requirement of Act 74, Mich. P.A. 1970

For corners in SECTION  
CHEBOYGAN

(County)	Located In:	Corner Code #
1. Public Land Survey	T <u>38N</u> R <u>3W</u>	<u>M-6</u>
	T _____ R _____	<u>A-6</u>
	T <u>38</u> R <u>2W</u>	_____
	T _____ R _____	_____
2. Property Controlling in Section	S _____ T _____ R _____	_____
	S _____ T _____ R _____	_____
3. Miscellaneous Property in Sec.	S _____ T _____ R _____	_____
	S _____ T _____ R _____	_____

RECEIVED FOR RECORD  
96 OCT 30 PM 12:13  
*Jeanne Spray*  
CLERK/REGISTER  
CHEBOYGAN COUNTY, MICHIGAN  
Register of Deeds Stamp & File Number

4. Lot No. \_\_\_\_\_, Recorded Plat \_\_\_\_\_  
5. Private Claims \_\_\_\_\_

I, JAMES H. GRANGER, in a field survey on OCTOBER 18, 1996, do hereby state that under requirements of P.A. 74, Michigan P.A. of 1970, the corner points mentioned in lines 1 and 2 above were in conformance with regulations and rules therefore as required in the current manual of survey instructions of the United States Department of the Interior, Bureau of Land Management or by a decree of a Court of Law and /or that the corner points mentioned in lines 3, 4 and 5 above were in conformance with the rules of the Michigan Board of Land Surveyors or by a Decree of a Court of Law; established, re-established, monumented, recovered, found as expressed below:

A	B	C	D	E	F	G	H	I	J	K	L	M
1												
2	6	5	4	3	2	1						
3												
4	7	9	9	10	11	12						
5												
6	18	17	16	15	14	13						
7												
8	19	20	21	22	23	24						
9												
10	30	29	28	27	26	25						
11												
12	31	32	33	34	35	36						
13												

NOTE: Not more than 2 corners, all in the same town and range, may be recorded on this certificate.


A. Description of original monument and accessories and/or subsequent restoration:

1840 - Original Survey Set wood post 10" Tamarack N42°E 8 lks  
John Mullett 8" Tamarack S50°W 12 lks  
1964 - DNR-LCRC Set 1" pipe w/4" brass cap  
Ken Larsen #10695

B. Description of corner evidence found and/or method applied in restoring or reestablishing corner:

Found 1" pipe with 4" brass cap and set four witnesses.

*Maurice A. Ray*

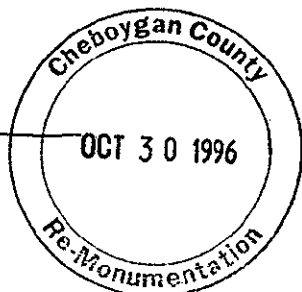

LIBER 010 PAGE 173

C. Description of monument for corner and accessories established to perpetuate locating the position of the corner:

also corner A-6, T38N, R2W

1" pipe

4" Balsam	N 47°W	9.33'
2" Poplar	N33°E	16.46'
3" Poplar	S20°E	1.57'
9" Poplar	S40°W	30.12'



Signed by James H. Granger  
Surveyor's Michigan License No. 16041

Date 10-18-96