

MAY 15 1997

CHEBOYGAN COUNTY REMONUMENTATION CORNER  
LAND CORNER RECORDATION CERTIFICATE  
Filing Requirement of Act 74, Mich. P.A. 1970

For corners in  
CHEBOYGAN

(County)	Located In:	Corner Code #
1. Public Land Survey	T <u>38</u> N R <u>3W</u>	<u>M-7</u>
	T <u>38</u> R <u>2W</u>	<u>A-7</u>
2. Property Controlling in Section	S <u>    </u> T <u>    </u> R <u>    </u>	<u>    </u>
3. Miscellaneous Property in Sec.	S <u>    </u> T <u>    </u> R <u>    </u>	<u>    </u>

RECEIVED FOR RECORD  
96 OCT 30 PM 12: 14  
*James H. Granger*  
CLERK/REGISTER  
CHEBOYGAN COUNTY, MICHIGAN  
Register of Deeds Stamp & File Number

4. Lot No. \_\_\_\_\_, Recorded Plat \_\_\_\_\_  
5. Private Claims \_\_\_\_\_

I, JAMES H. GRANGER, in a field survey on OCTOBER 18, 19 96 do hereby state that under requirements of P.A. 74, Michigan P.A. of 1970, the corner points mentioned in lines 1 and 2 above were in conformance with regulations and rules therefore as required in the current manual of survey instructions of the United States Department of the Interior, Bureau of Land Management or by a decree of a Court of Law and for that the corner points mentioned in lines 3, 4 and 5 above were in conformance with the rules of the Michigan Board of Land Surveyors or by a Decree of a Court of Law; established, re-established, monumented, recovered, found as expressed below:

A	B	C	D	E	F	G	H	I	J	K	L	M
1												
2	6	5	4	3	2	1						
3												
4	7	8	9	10	11	12						
5												
6	18	17	16	15	14	13						
7												
8	19	20	21	22	23	24						
9												
10	30	29	28	27	26	25						
11												
12	31	32	33	34	35	36						
13												


NOTE: Not more than 2 corners, all in the same town and range, may be recorded on this certificate.

A. Description of original monument and accessories and/or subsequent restoration:

1840 - Original Survey Set wood post 14" Cedar S36°E 14 lks  
John Mullett 12" Cedar N31°W 19 lks  
1964 - DNR-LCRC Set 1" pipe w/4" brass cap  
Ken Larsen #10695

B. Description of corner evidence found and/or method applied in restoring or reestablishing corner:


Found 1" pipe with 4" brass cap, 2 scribed witnesses and a 4" squared post.

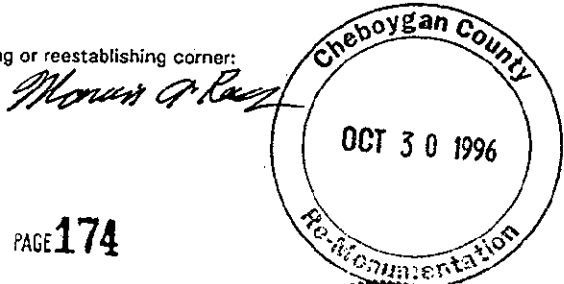

LIBER 010 PAGE 174

C. Description of monument for corner and accessories established to perpetuate locating the position of the corner:

also corner A-7, T38N, R2W  
1" pipe  
8" Cedar S 66°E 11.29'  
14" Poplar S45°W 27.22'  
6" Birch N85°W 10.23'  
4" Balsam N12°E 16.91'

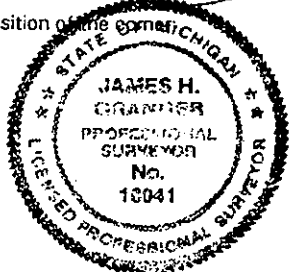

Signed by James H. Granger  
Surveyor's Michigan License No. 16041

Date 10-18-96